


T.19S. R.1W., W.M.

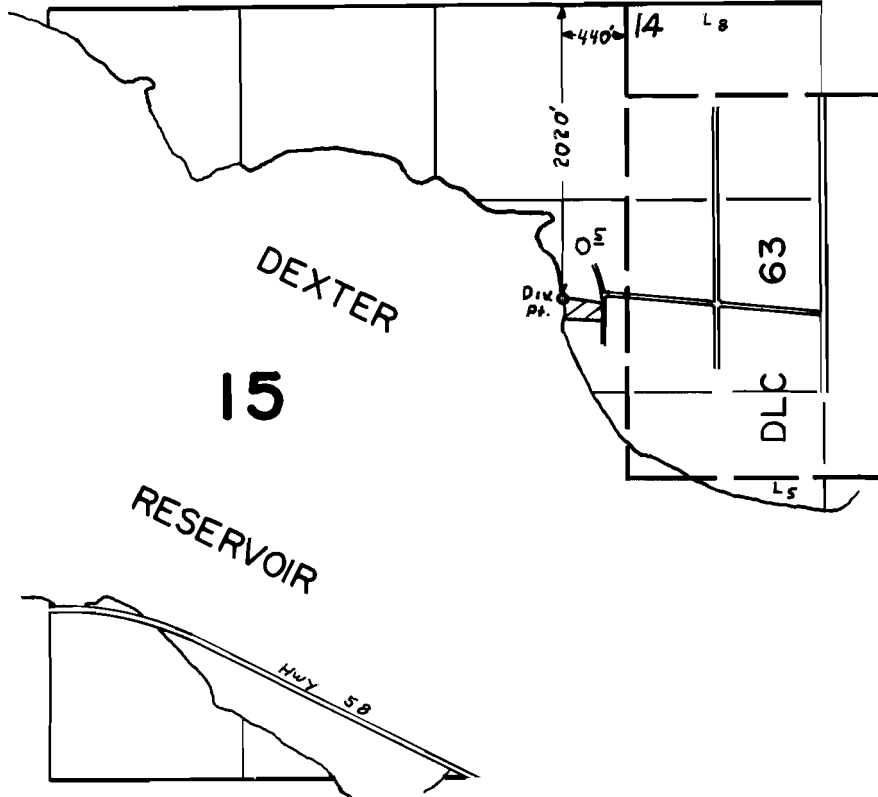

FINAL PROOF SURVEY UNDER

Application No. 53322... Permit No. 39565...
IN NAME OF

.....NEAL J. LUKE.....

Surveyed MAR. 30. 1978, by J. S. DONALDSON