


T.21S. R.4W., W.M.

NE 1/4 NE 1/4 SEC 24

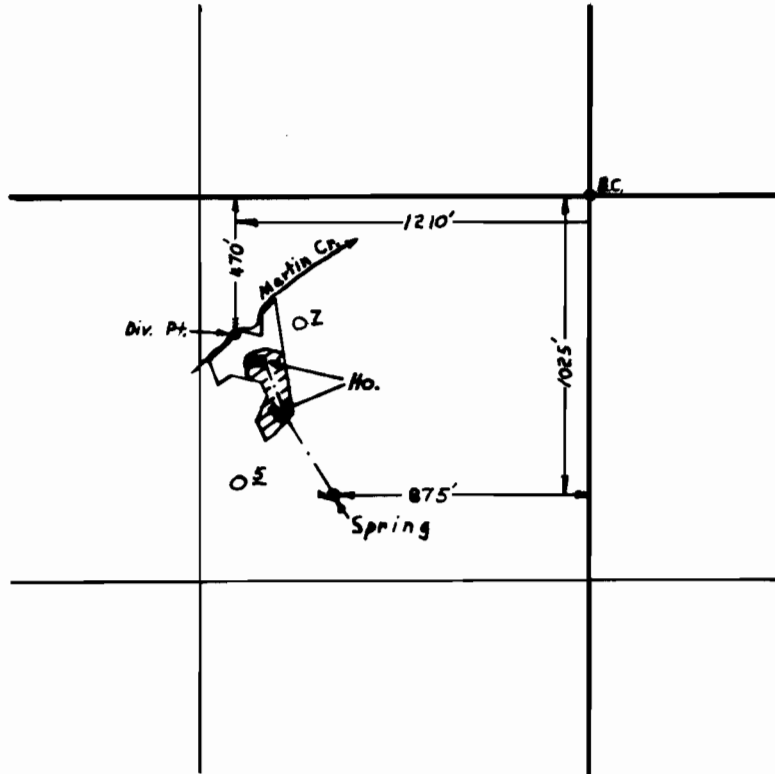

Scale: 1" = 660'

FINAL PROOF SURVEY UNDER

Application No. 55068... Permit No. 41294....
IN NAME OF

.....MAYBELLA COMSTOCK.....

Surveyed MAR. 28, 1978., by J.S. DONALDSON