


Plan No. 5563
5030

Township 1 South

Range 17 EAST W M

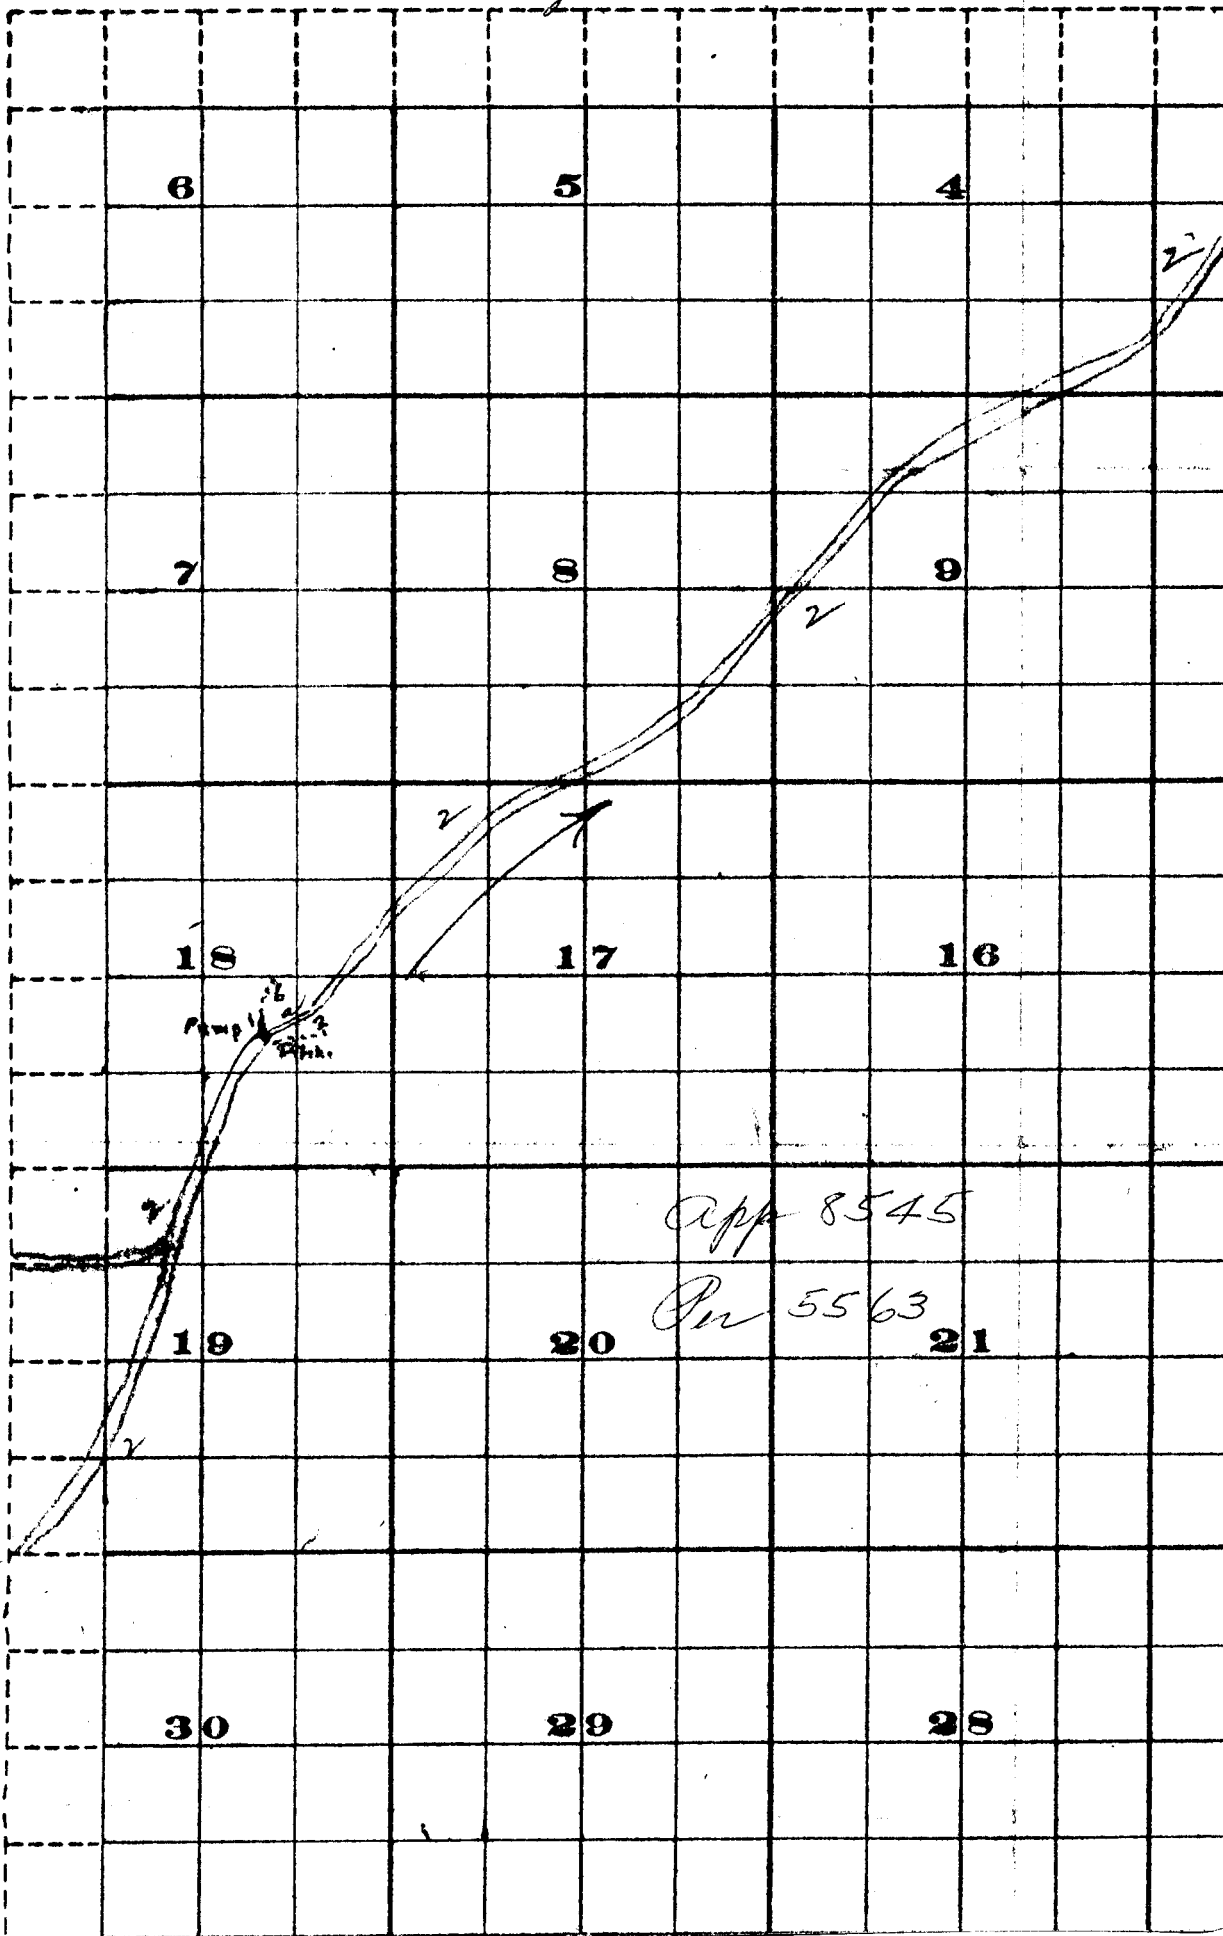

1 = piece of dimension which is 510 feet north and 388 feet west of the S.E. cor of the N¹/₄ and as the point of dimension there is a corner from 2 feet high and 22 feet long. Successive N¹/₄ of the S.E¹/₄ of Sec 15 24 15. R. 17 East 24. M. 4¹/₂ East and that corner to be marked by the stl in of Sec 18, 24 15. R. 17 E. 24. M.

2 = corner or point from which water is taken.

2 = 7 E. 70 feet stl in the canyon with the figure 1 as piece of dimension and then in Sec 18.