


T.10S., R.3W., W.M.

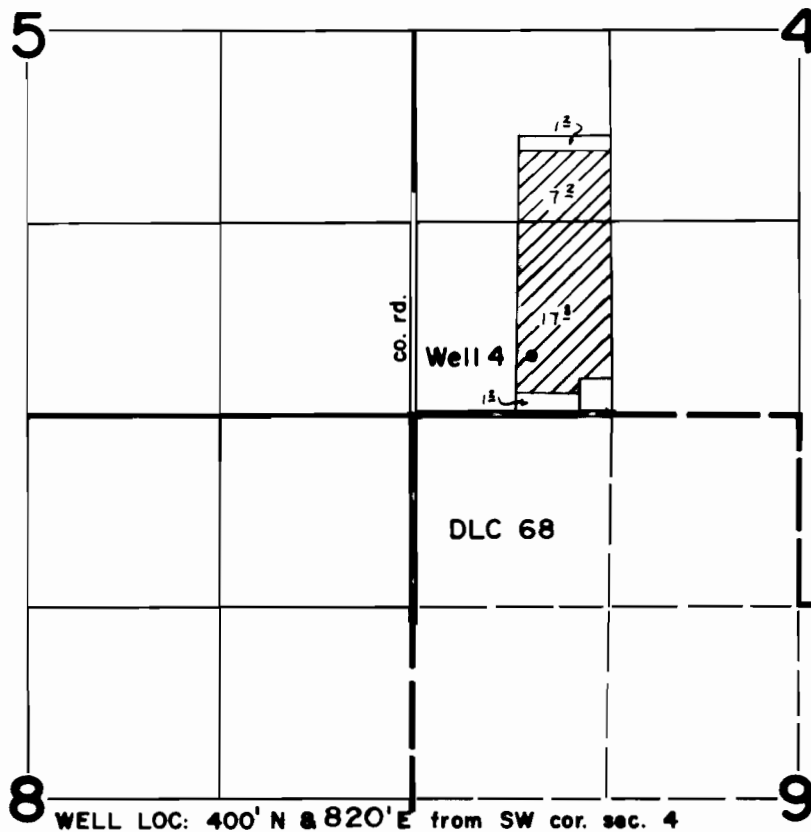

FINAL PROOF SURVEY
UNDER

Application No. G-6002 Permit No. G-5710
IN NAME OF

GLEN & JACQUELINE GHORMLEY

Surveyed April 12 1976, by D. Norby
" April 23, 1979 by S.C. BROWN