


T.11S.,R.2W.,W.M.

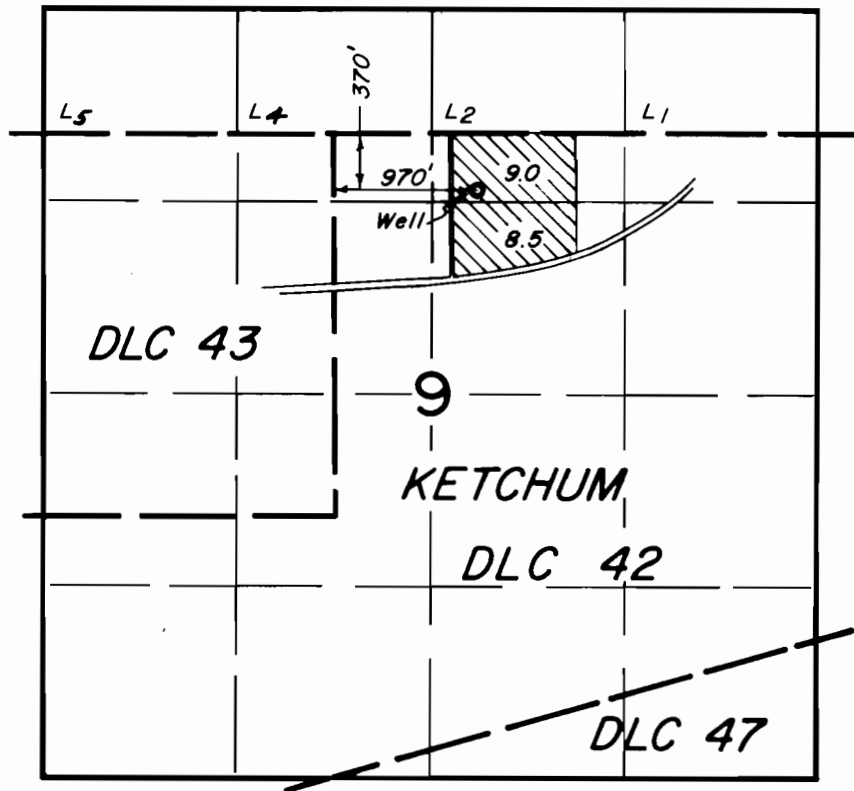

FINAL PROOF SURVEY UNDER

Application No. G-6033 Permit No. G-5716...
IN NAME OF

Robert J. & Eileen Ann Houston

Surveyed Sept. 6, 1978, by S. DONALDSON