


T.10S. R.2W., W.M.

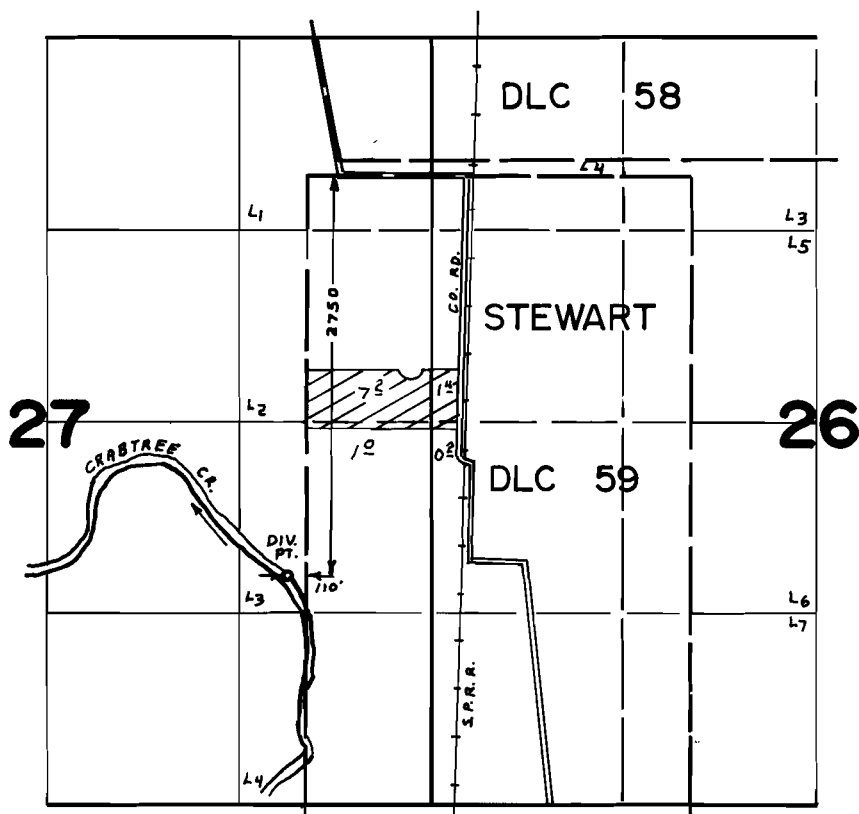

FINAL PROOF SURVEY UNDER

Application No. 55286... Permit No. 41480...
IN NAME OF

Marion & Joyce Lenhardt

Surveyed APR. 12, 1978, by S.P. APPLGATE