


# T.IOS. R.IE., W.M.

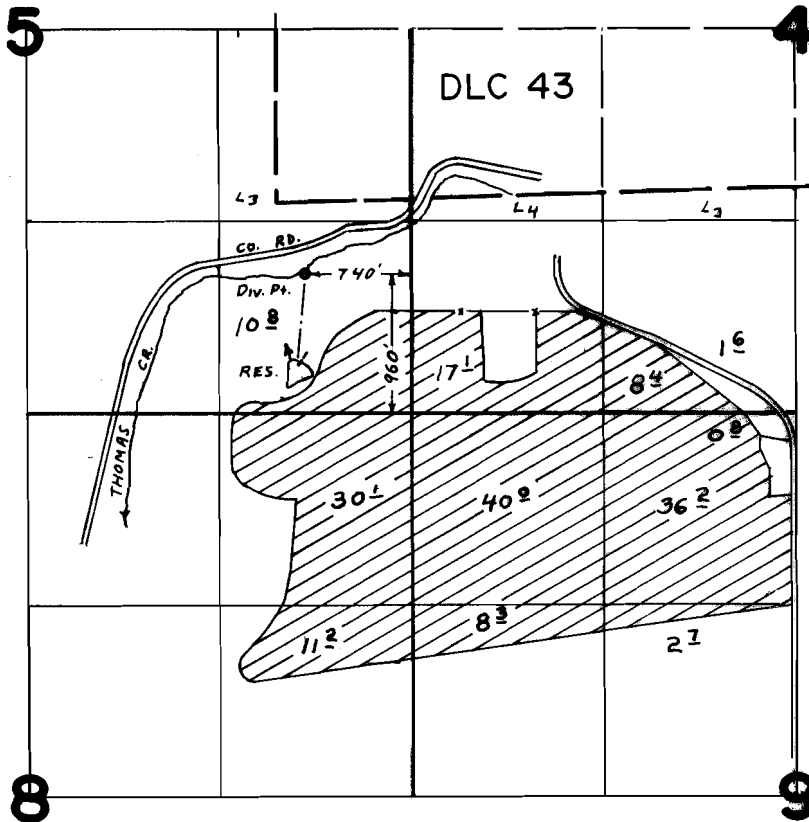

## FINAL PROOF SURVEY UNDER

52778                      39844  
Application No. R-53707 Permit No. R-6387  
IN NAME OF

JOHN GILLETT

Surveyed MAY 30 1978, by S. P. APPLGATE