


T.5S. R.1&2W., W.M.

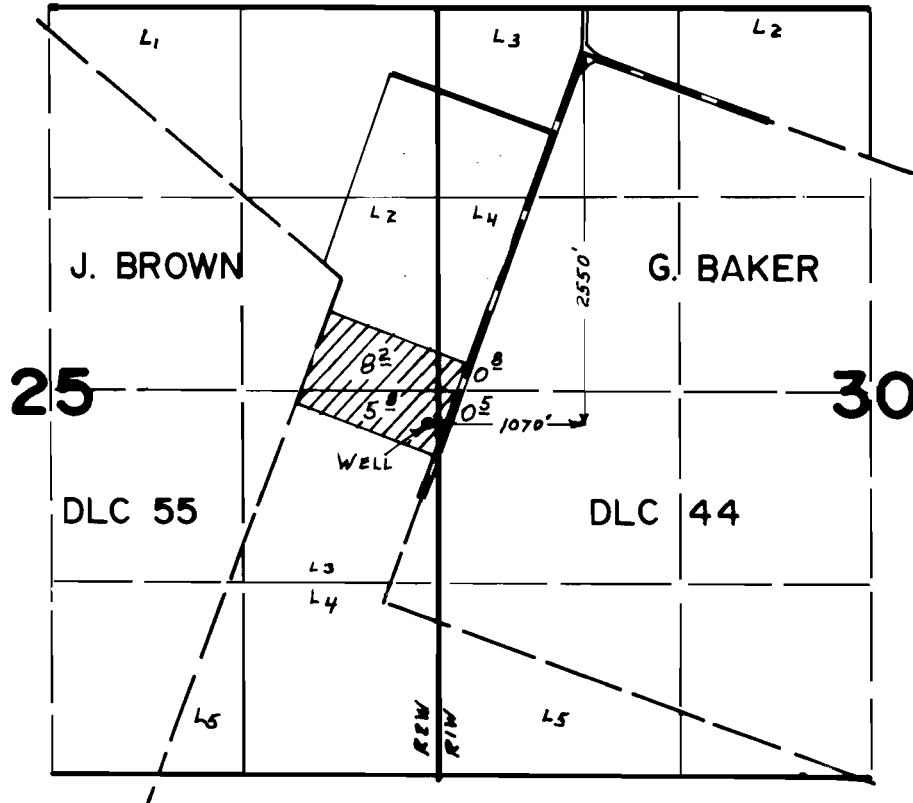

FINAL PROOF SURVEY UNDER

Application No. G-5546. Permit No. G-5425.
IN NAME OF

.....LYMAN EDER.....

Surveyed SEP. 29. 1978. by S.P. APPLGATE