


T.8S. R.3W., W.M.

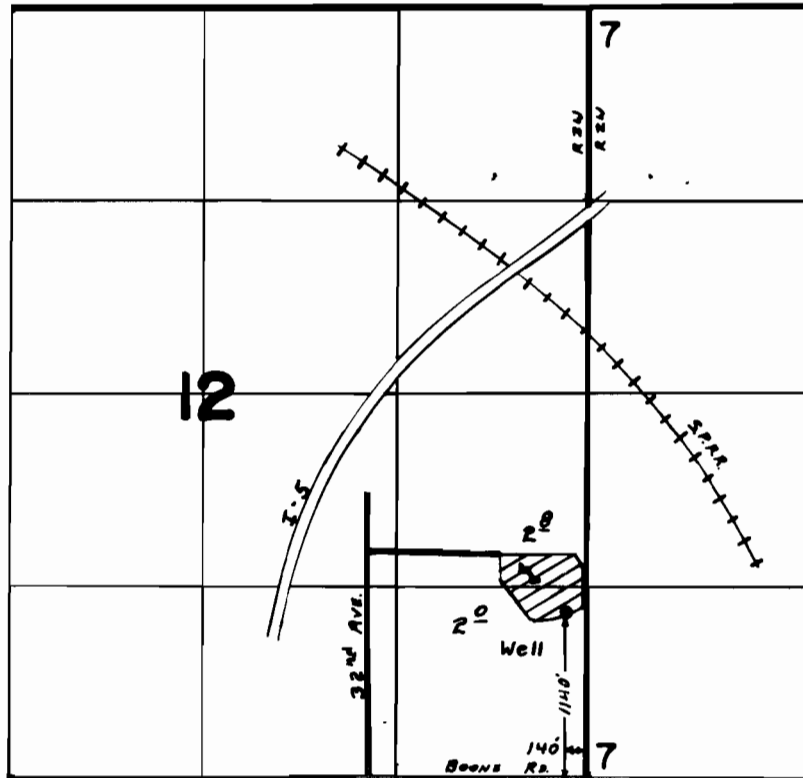

FINAL PROOF SURVEY UNDER

Application No. G-7716... Permit No. G-7167...
IN NAME OF

MRS. DARREL W. LITCHFIELD.....

Surveyed OCT. 18, 1978, by S. P. APPLIGATE