


T. 8 S., R. 4 W., W.M.

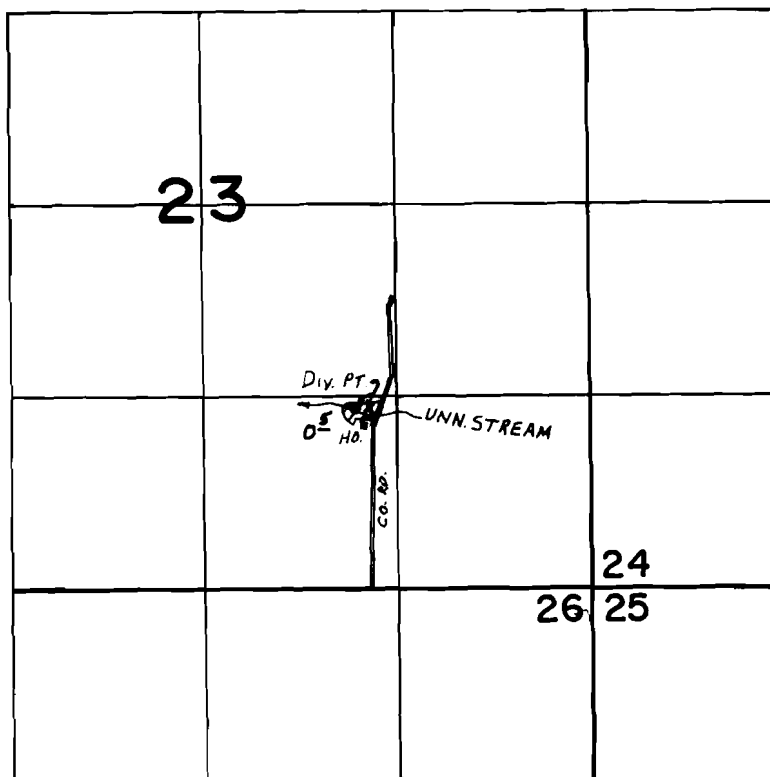

DIV. PTS. LOC. 1200' N. & 1520' W.; 1230' N. & 1610' W.,
BOTH FROM SE COR. SEC. 23.

FINAL PROOF SURVEY
UNDER

Application No. 54859 Permit No. 41150...
IN NAME OF

RODNEY P. OULLETTE

Surveyed OCT. 18, 1978, by S. P. APPLGATE