T.4S. R.2W. W.M.

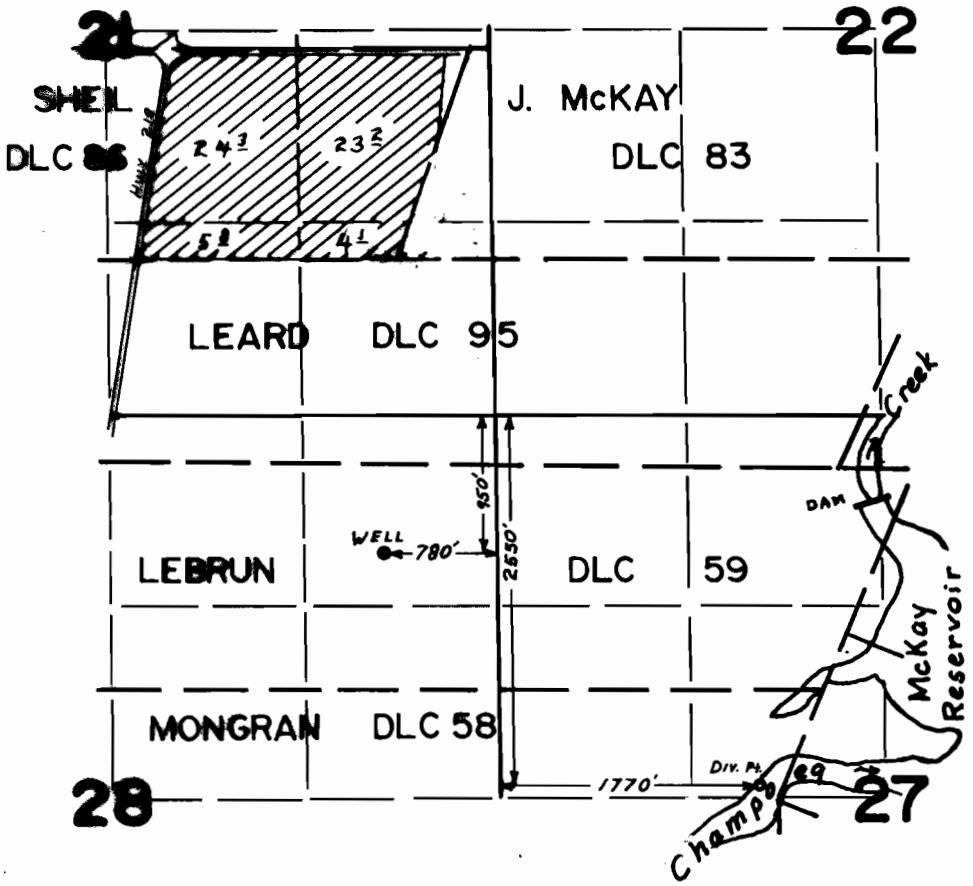

DAM LOCATED: 1400'S & 2090'W FROM W'LY INT "L" COR KENNEDY DLC 49

FINAL PROOF SURVEY
UNDER

Application No. G-8019 55663 Permit No. G-7933 42760
IN NAME OF

McKAY ACRES, INC.

Surveyed SEP 29 1978, by S.P. APPLEGATE