


T4S. R9W. WM.

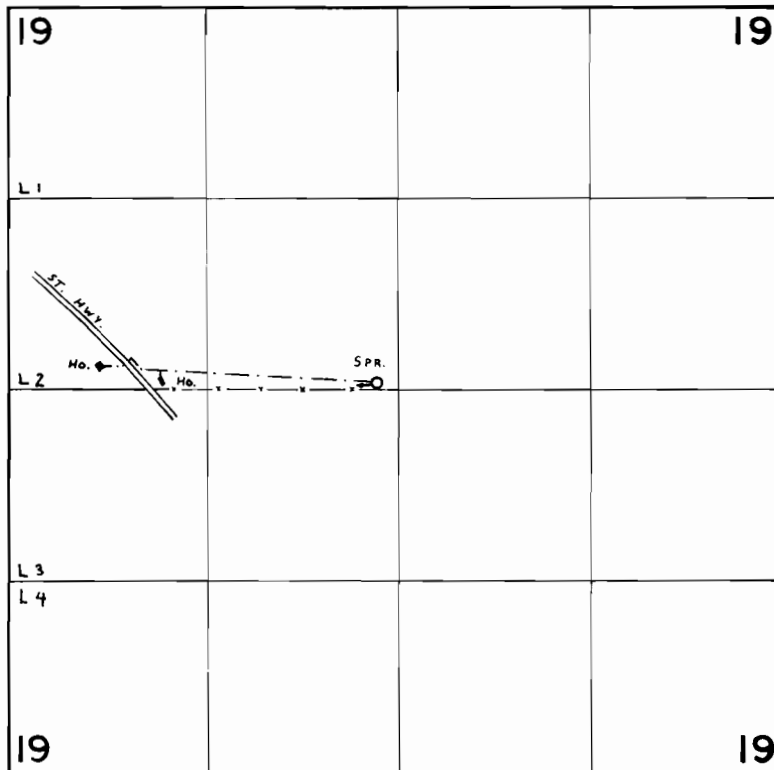

SPR. Loc: 50' N & 2520' E. fr. W $\frac{1}{4}$ COR. SEC. 19.

FINAL PROOF SURVEY UNDER

Application No. 49127 Permit No. 36838
IN NAME OF

William Beene & Debra Perry

Surveyed SEPT. 13 1978, by C. L. HUGHES