


T1S. R13E. WM.

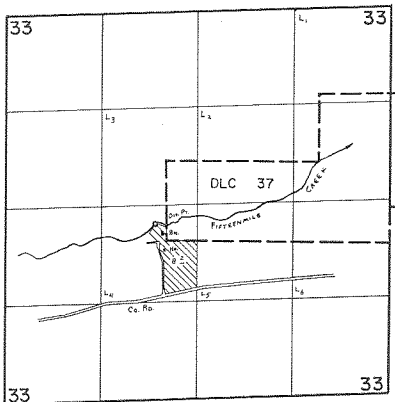

Div. Pt. Loc: 2470' N. & 2050' E. fr. SW. Cor. Sec. 33.

**FINAL PROOF SURVEY**  
UNDER

Application No. 49336. Permit No. 36986.....  
IN NAME OF

**KATHYLEEN D. & CHARLES E. LARIE**

Surveyed June 27, 1979, by C. L. HUGHES.....