


T1S. R13E. WM.

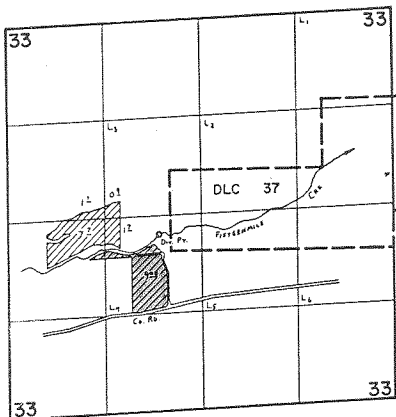

Div. Fr. Loc: 2970' N. of 2050' W. fr. S.W. Cor. Sec. 33.

FINAL PROOF SURVEY UNDER

Application No. 49337 Permit No. 36987
49338 Permit No. 36988
 IN NAME OF

HARRIET & WILFORD MOE

Surveyed June 27, 1979, by C. L. HUGHES