T. 13S. R. 6W. W.M.

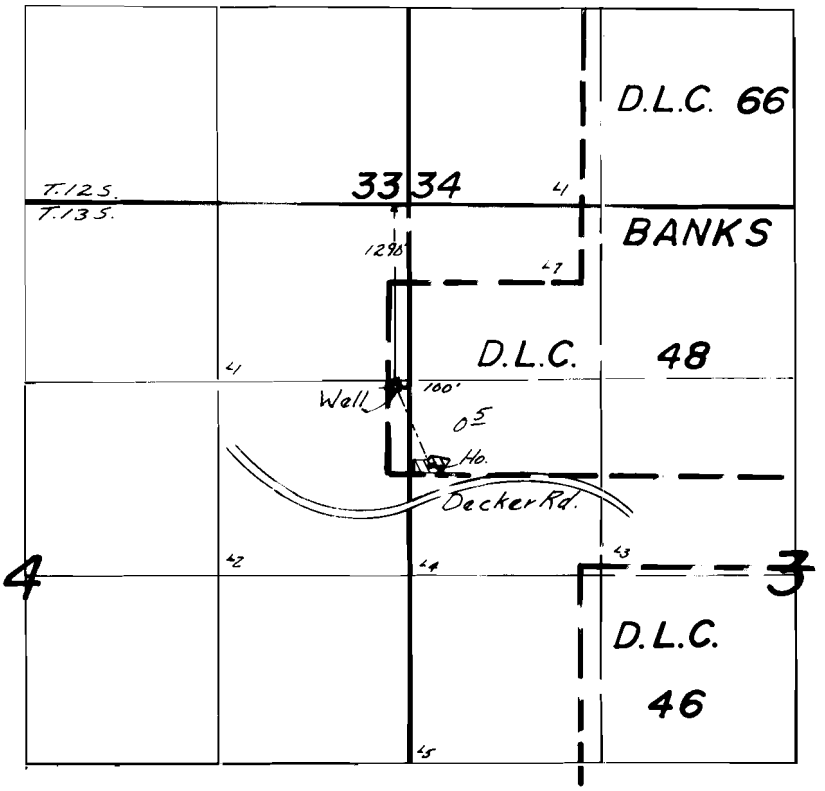

FINAL PROOF SURVEY
UNDER

Application No. G-5661 Permit No. G-5488
IN NAME OF

David H. & Barbara R. Wardsworth

Surveyed Oct. 17 1978, by J.S. Donaldson

DFT-4LL-17