


T. IS. R. 4<sup>1</sup>5E. W.M.

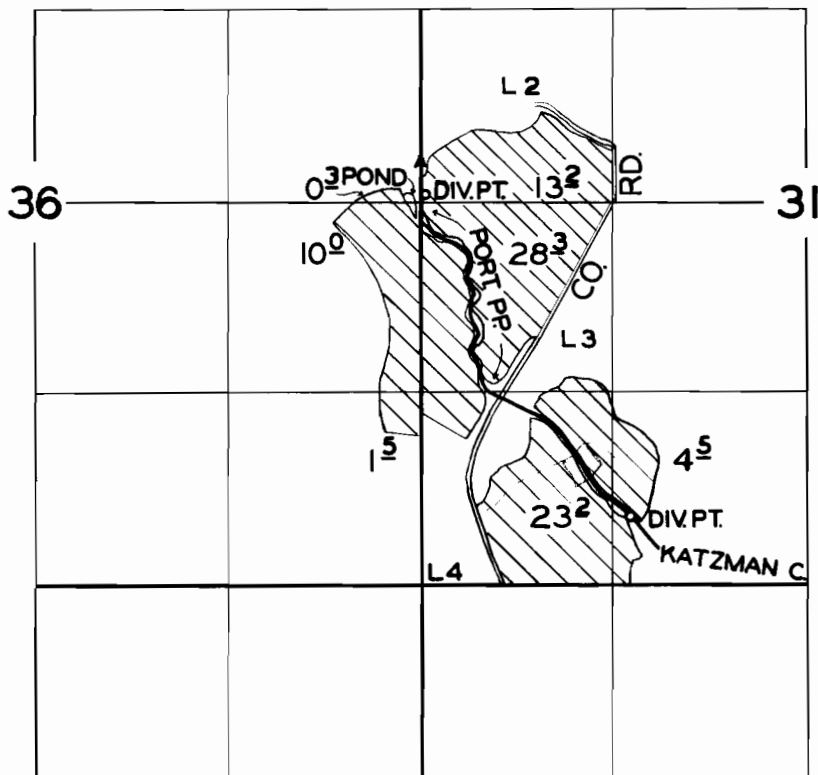

**FINAL PROOF SURVEY**  
UNDER

Application No. **21983** Permit No. **17288**

IN NAME OF

**A. H. HORNING**

Surveyed **11 JUNE**, 1956, by **R. D. BEST**