


# T3S. R1E. WM.

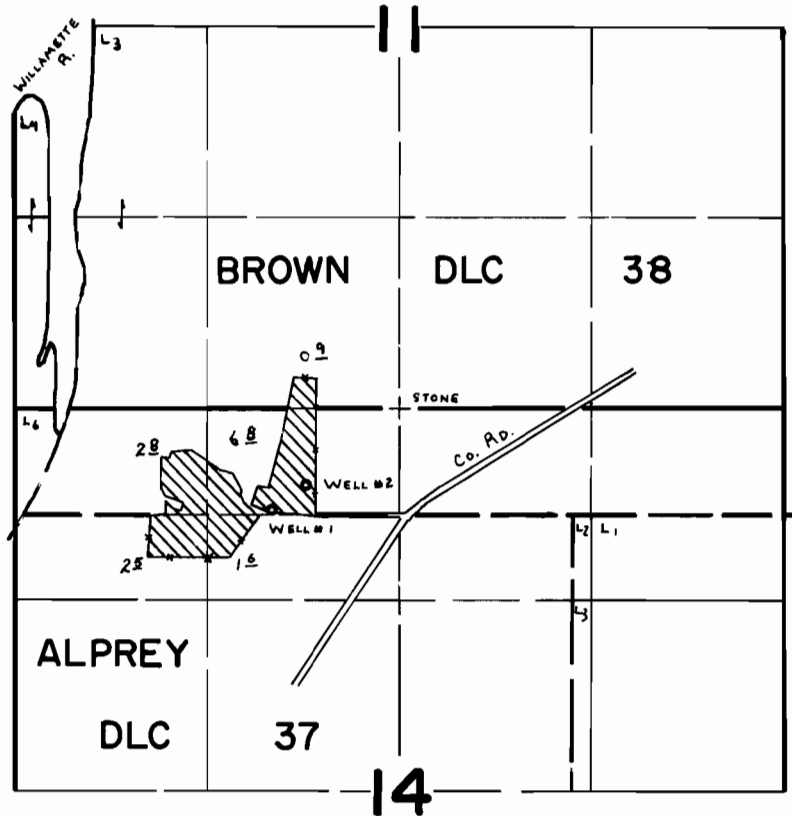

WELLS LOC: #2 - 520'S. & 640' W. } BOTH FROM N. 1/4 COR. SEC. 14.  
 #1 - 690'S. & 870' W. }

## FINAL PROOF SURVEY UNDER

Application No. G-6848 Permit No. G-6389  
 IN NAME OF

R. R. SAMUELS

Surveyed SEPT. 27 1978, by C. L. HUGHES