


T.26S.,R.6 W.,W.M.

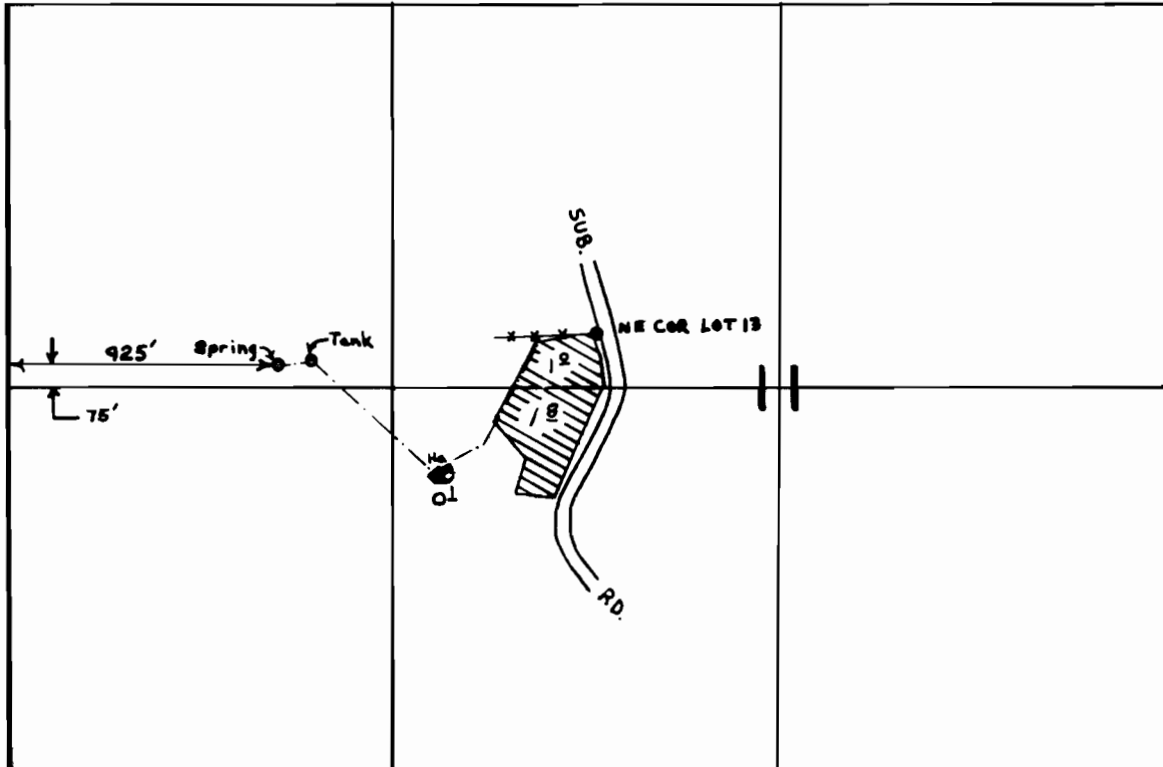

SCALE: 1" = 660'

FINAL PROOF SURVEY
UNDER

Application No. 49318 Permit No. 36976
IN NAME OF

JAKE B. SWINDLER

Surveyed OCT. 10 1977, by D.W. SPARKS