


T.40S.,R.8W.,W.M.

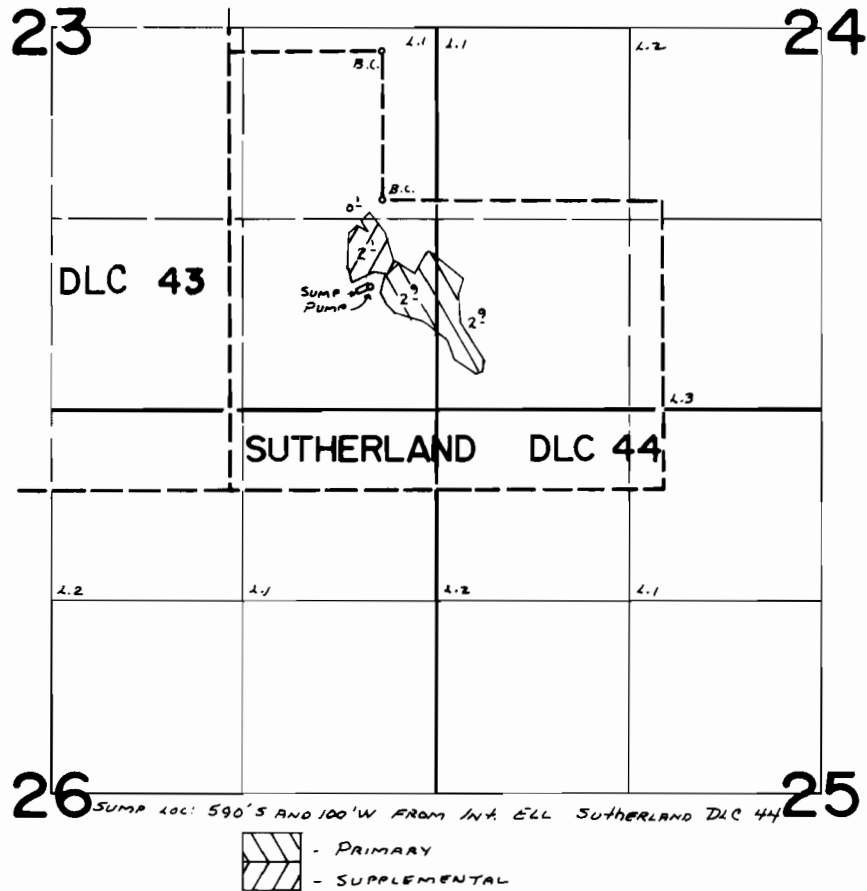

FINAL PROOF SURVEY UNDER

Application No. G-3707 Permit No. G-3507
IN NAME OF

RAY W. REYNOLDS

Surveyed MAY 1 1975, by L. Tall