
## T.6 S. R.I E. W. M.

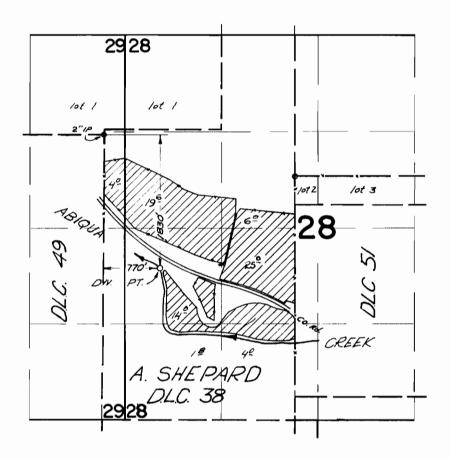

## FINAL PROOF SURVEY

Application No. 3878/ Permit No. 28850 IN NAME OF

WILLIAM F FESSLER

Surveyed Nor. 27 1967, by V. Garner