


T.1S. R.38E. W.M.

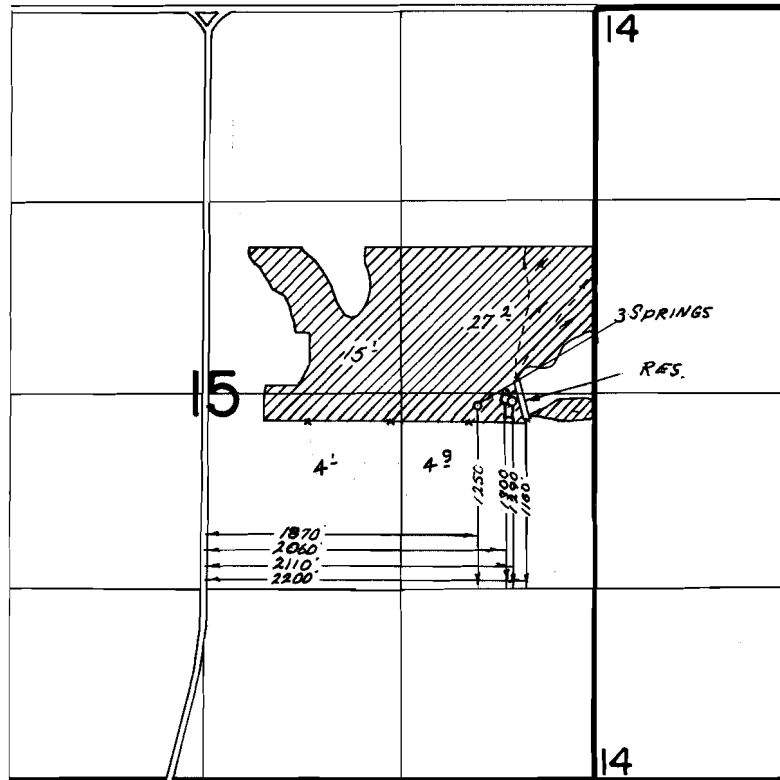


FINAL PROOF SURVEY
UNDER

Application No. R-49537 Permit No. R-5033
49537 32748
IN NAME OF

BERNICE YORK

Surveyed JULY 10, 1973, by R. B. MUCKEN

T.1S. R.38E. W.M.

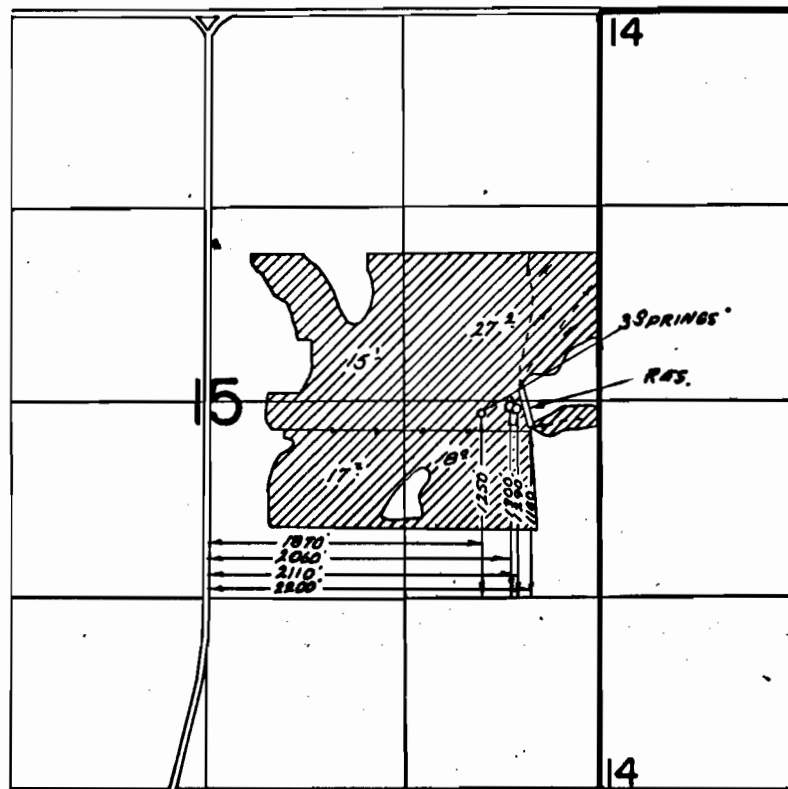

FINAL PROOF SURVEY
UNDER

Application No. R-49537 Permit No. R-5033
49537 52748
IN NAME OF

BERNICE YORK

Surveyed July 10, 1979, by R. B. MUCKEN