


T. 7S. R. 40E. W.M.

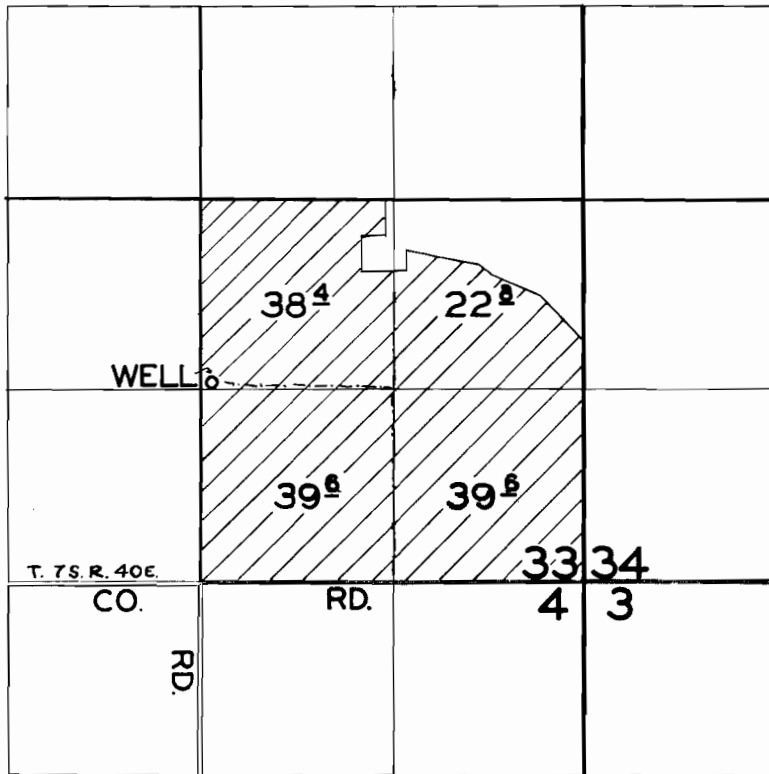

FINAL PROOF SURVEY

UNDER

Application No. U-754 Permit No. U-669

IN NAME OF

CHARLES H. COLTON

Surveyed 25 MAY 1956, by M. BISH

flw