


T. 26 S. R. 6 & 7 W. W. M.

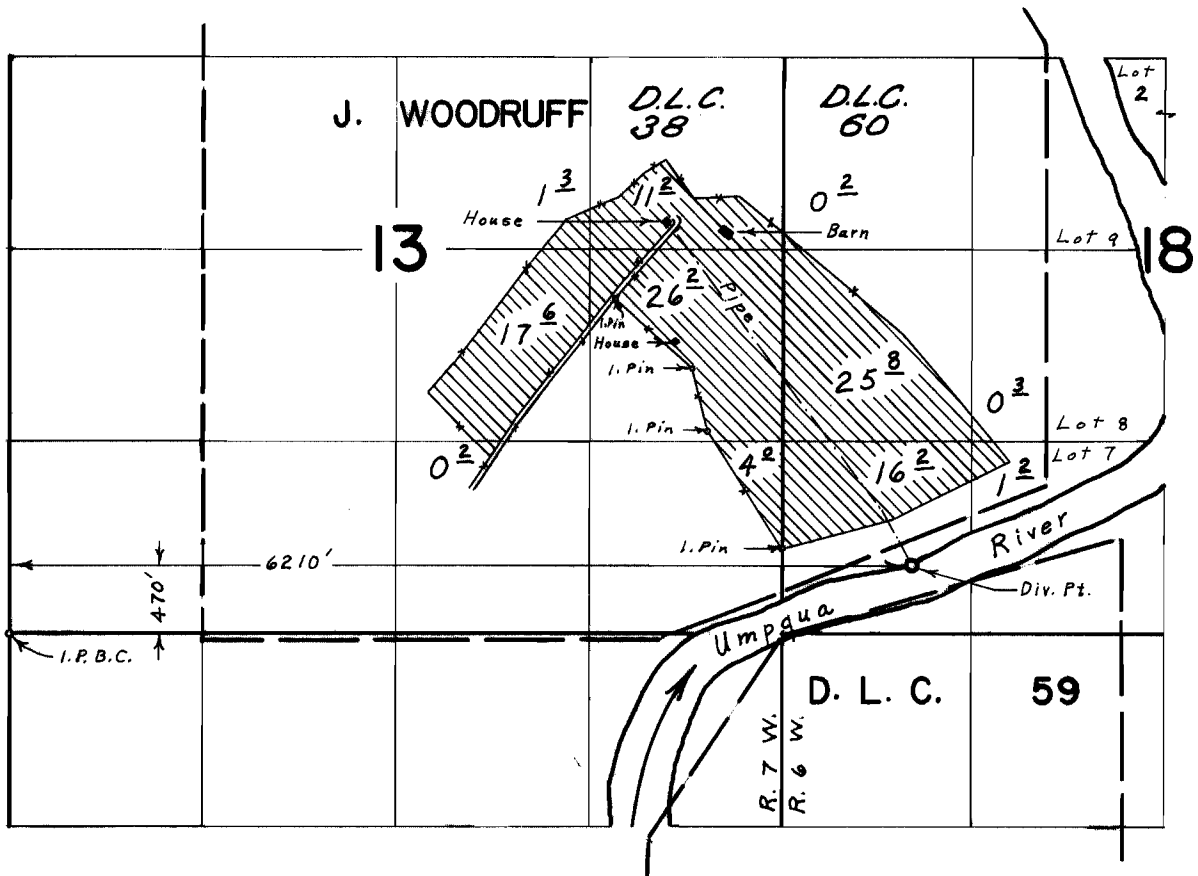

FINAL PROOF SURVEY UNDER

Application No. 39035 Permit No. 29072

IN NAME OF

JOHN MCKEE

Surveyed June 6, 1967, by L. E. Gould