


T. 32S., R. 3W., W.M.

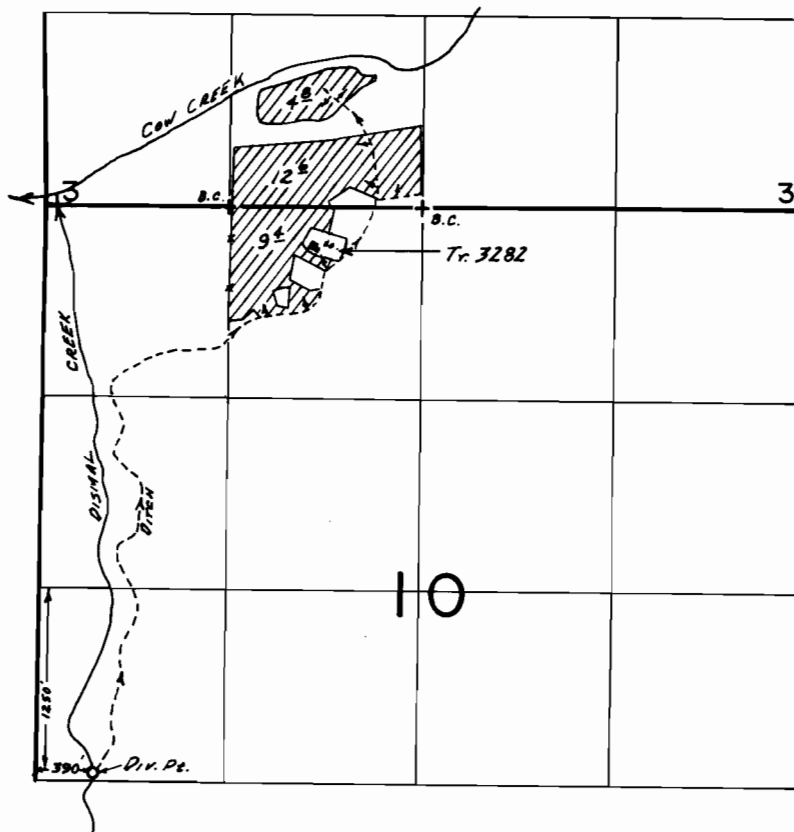

FINAL PROOF SURVEY
UNDER

Application No. 45095... Permit No. 33701.....
IN NAME OF

ANDREW H. MARLINE & ESTHER KOCH

Surveyed May 12..... 1977, by D.M. NORBY.....
July 15 1980 J.S. DONALDSON