


T. 26 S., R. 3 W., W.M.

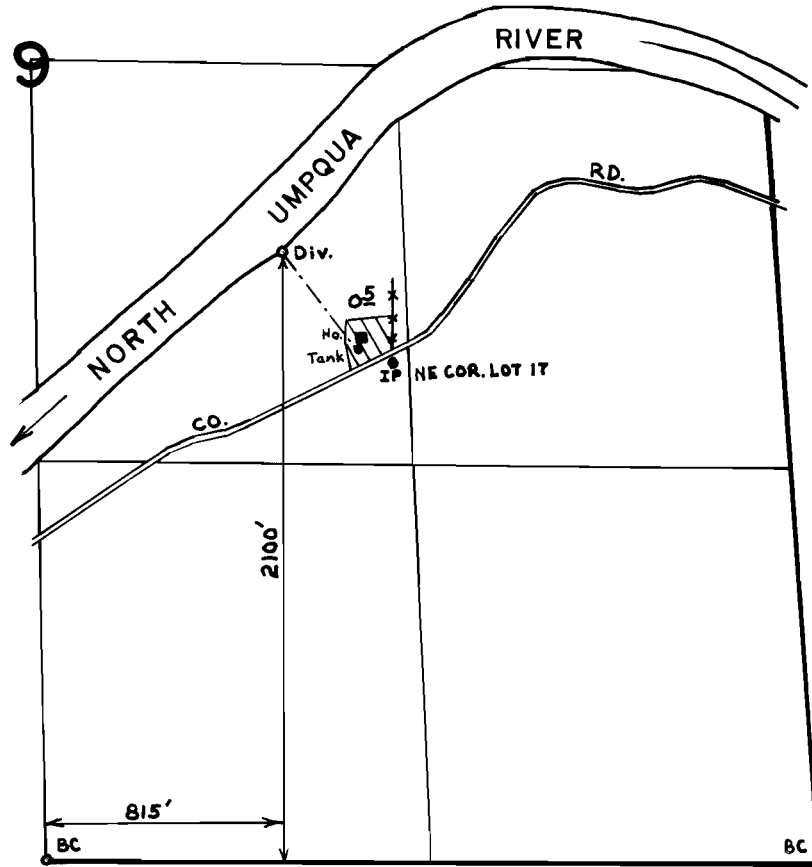

SCALE: 1" = 660'

**FINAL PROOF SURVEY**  
UNDER

Application No. 52342... Permit No. 39365...  
IN NAME OF

PAUL G. HUGHES

Surveyed OCT. 18... 1978, by D.R. HENRY.....