


G- 4741
50364
50365

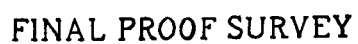

UNDER

Application No. ~~6-4408~~ ⁶⁻⁴⁴⁰⁸ Permit to ~~6-4302~~ ⁶⁻⁴³⁰²
~~6-3827~~ ⁶⁻³⁸²⁷ ~~6-4741~~ ⁶⁻⁴⁷⁴¹

IN NAME OF
PLATEAU FARMS

Surveyed April 5, 1974, by L. E. Gould.