


T23S. R33E. WM.

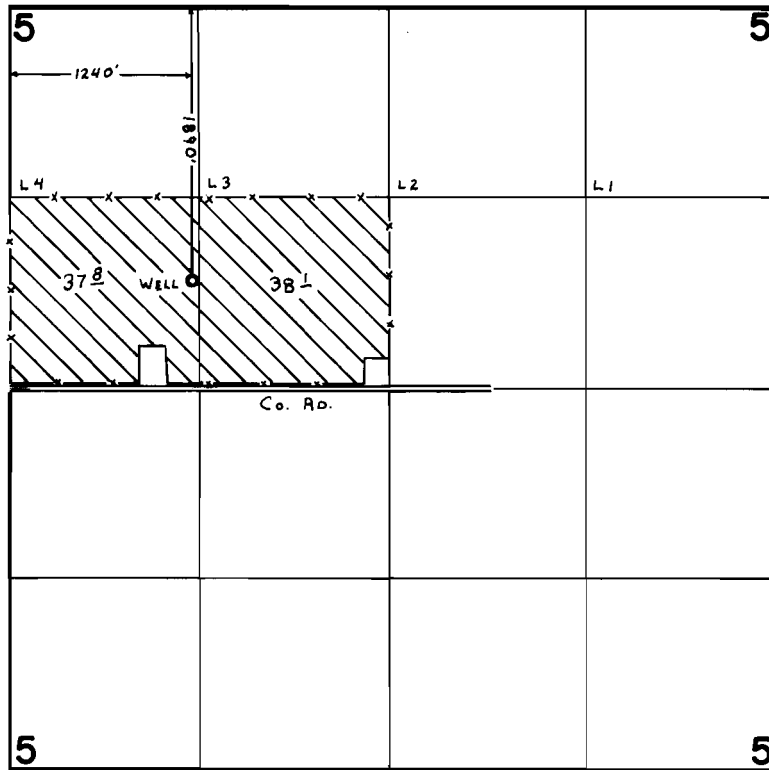

FINAL PROOF SURVEY UNDER

Application No. G-8239 Permit No. G-7640
IN NAME OF

ARLIN J. & ODELL C. LAWSON

Surveyed AUG. 29. 1978, by C. L. HUGHES