

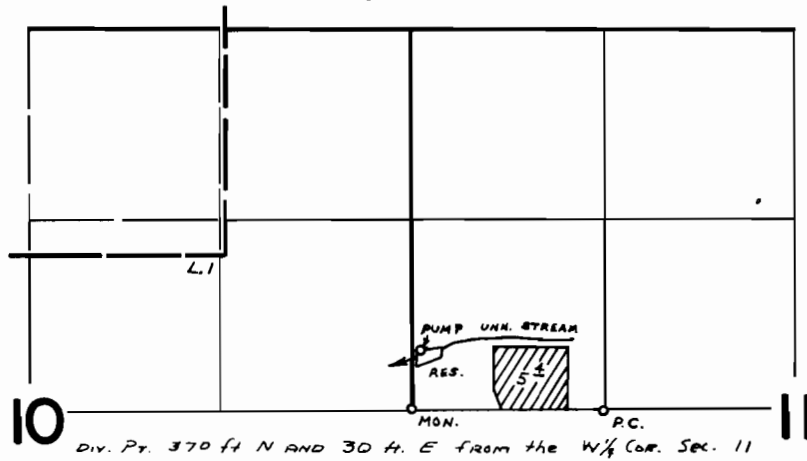


# T.36S.,R.IW.,W.M.

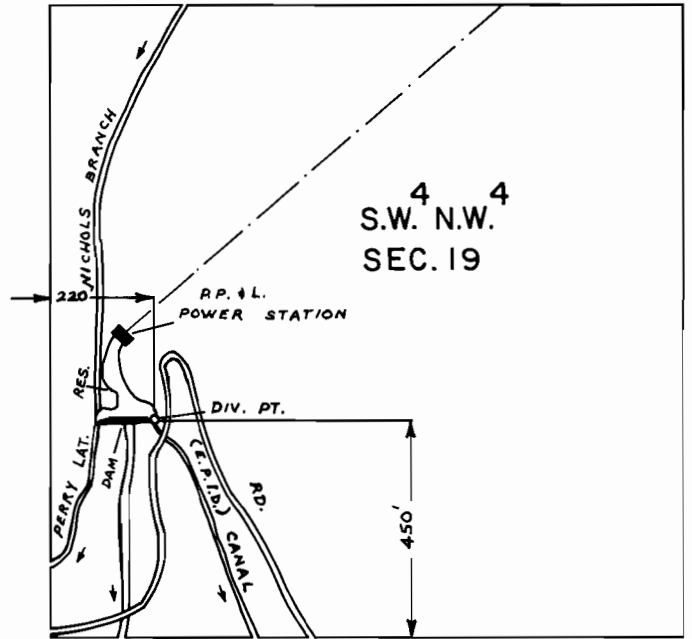

# T.36S.,R.IW.,W.M.

# T.35S.,R.IE.,W.M.

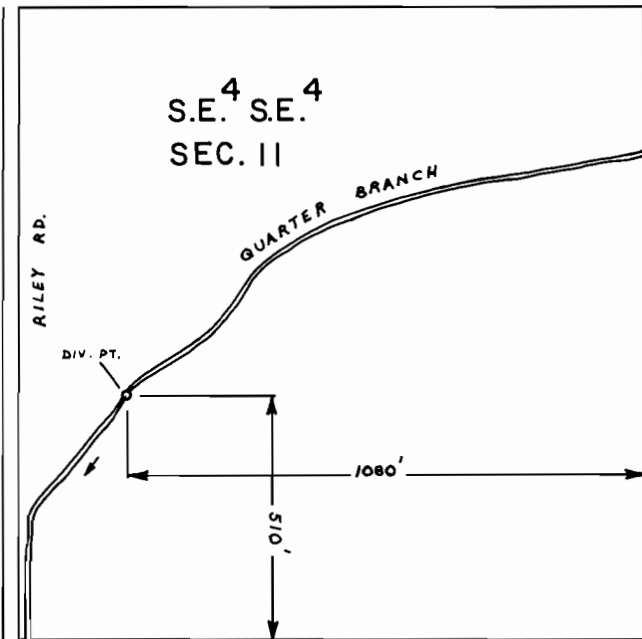

SCALE: 1" = 400 FT.

## FINAL PROOF SURVEY UNDER

Application No. R-48881 Permit No. R-5933  
48882 36623  
 IN NAME OF

MORRIS ARTHUR

Surveyed AUG. 20 1975 by L. E. GOULD  
DEC. 14 1979 B. SUND

L.M.T.  
 P.T.S. - 1975 - M  
 D.H.M.  
 PHOTOS: 82 & 93  
 (E.P.I.D.)