


T.35 S., R.3 W., W.M.

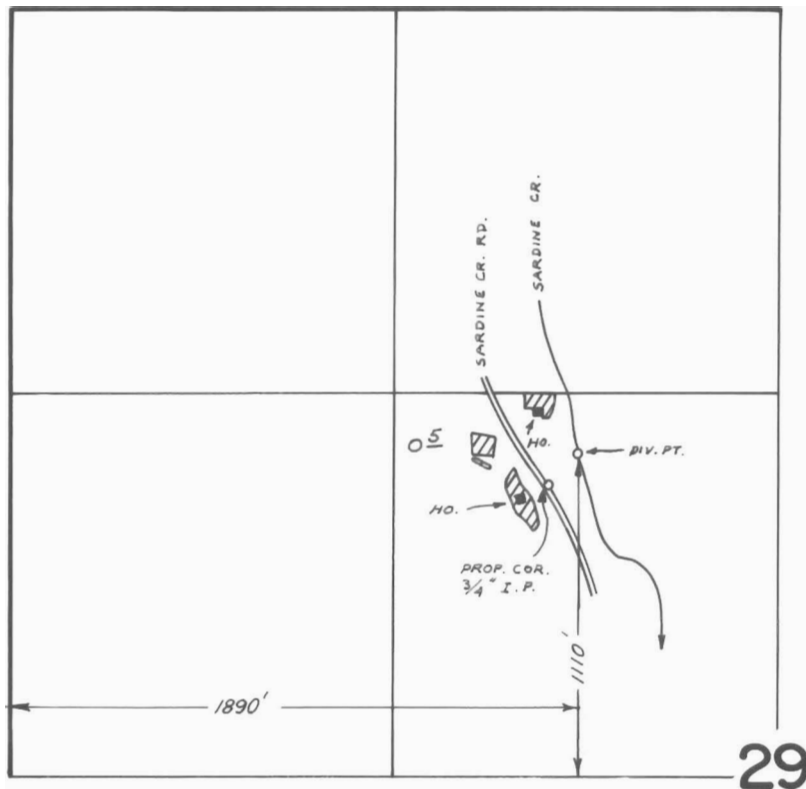

SCALE : 1" = 660 FT.

FINAL PROOF SURVEY
UNDER

Application No. 49536 Permit No. 37076
IN NAME OF

KATHERINA M. PAULUS

Surveyed SEPT. 20 1978, by B. SUND