


T.37S., R.4 W., W.M.

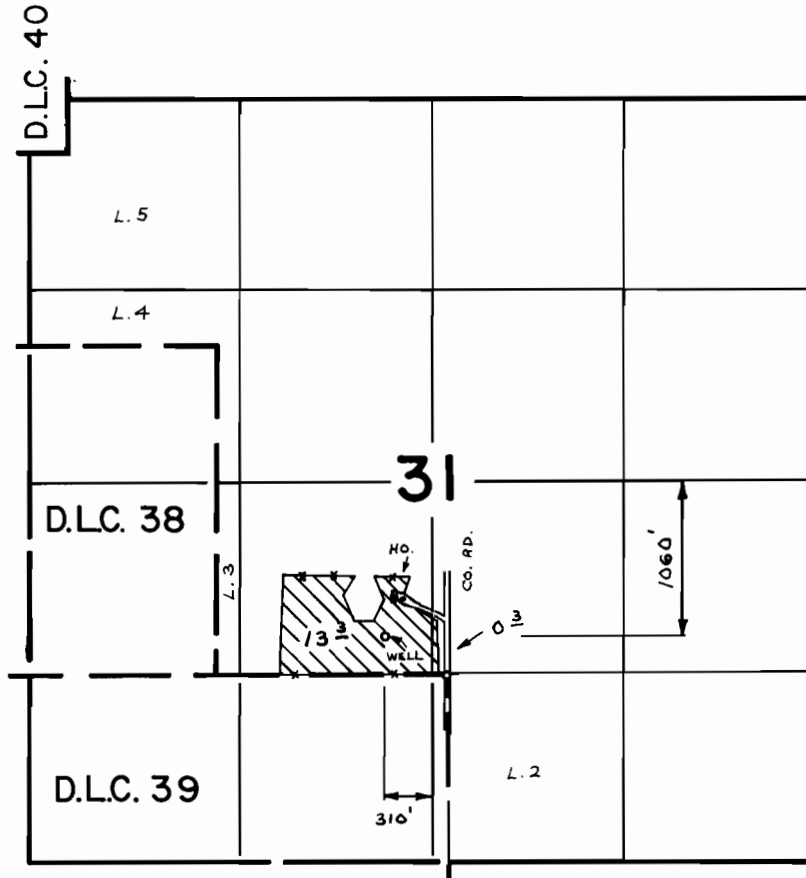

FINAL PROOF SURVEY UNDER

Application No. G-6587 Permit No. G-6175
IN NAME OF

BEVERLY A. SAUL

Surveyed JUL. 10 1978, by B. SUND

D. H. M.

P.T.S. - 1978-14-A