


# T.40 S.R.8 W.W.M.

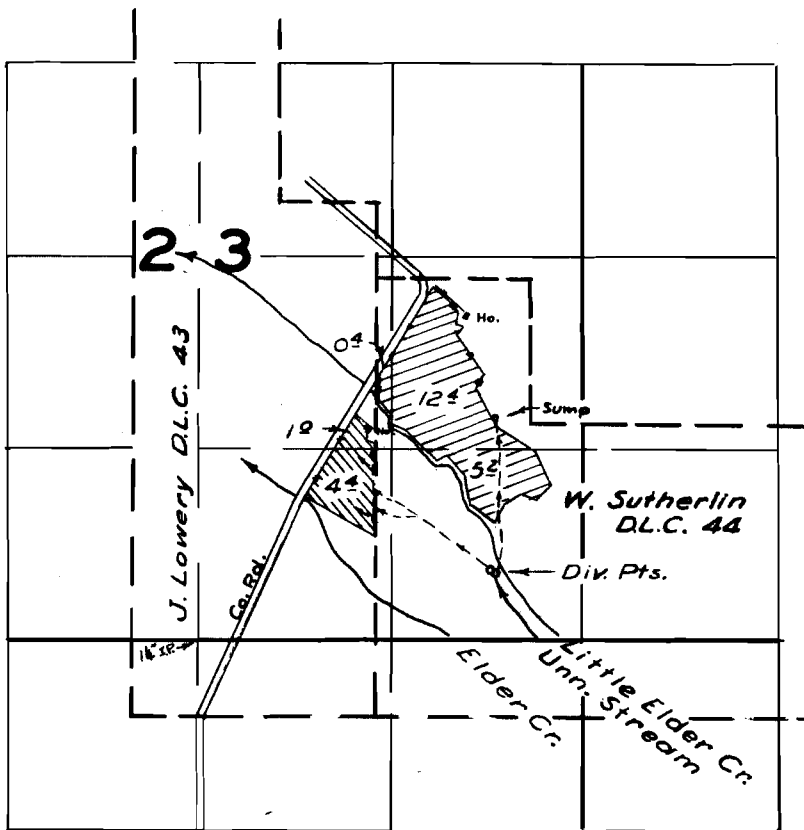

Hanby   
Buckendahl 

## FINAL PROOF SURVEY UNDER

Application No. 27488 Permit No. 21636  
IN NAME OF

DOUGLAS V. HANBY & ARNOLD W. BUCKENDAHL

Surveyed 14 July 1959, by M. Bish