


T.36 S., R.5 W., W.M.

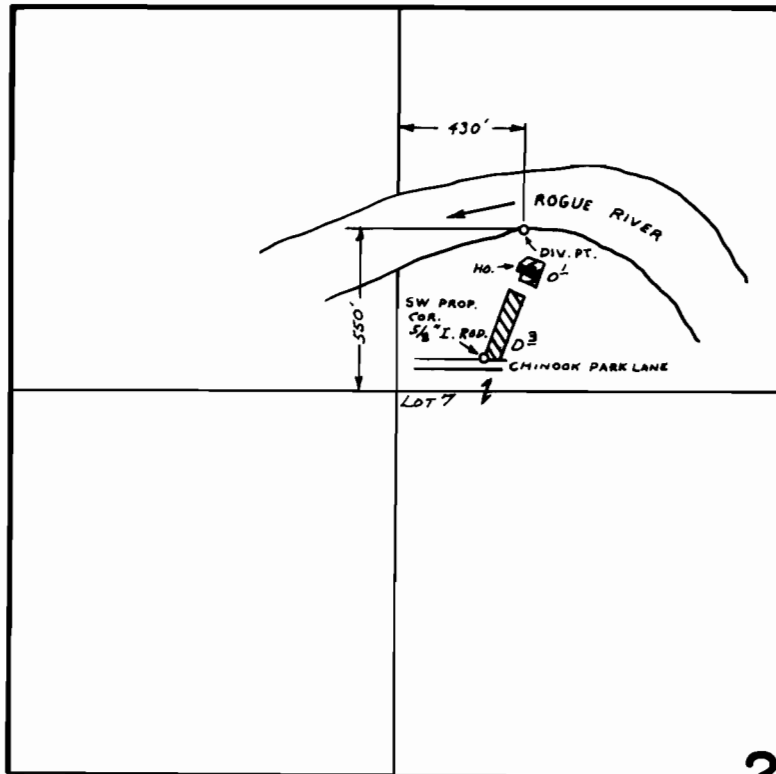

23

▨ IRRIGATION
▩ IRRIGATION & FROST CONTROL
SCALE: 1" = 660 FT.

FINAL PROOF SURVEY UNDER

Application No. 55176 Permit No. 42220
IN NAME OF

FLOYD F. SHANECK

Surveyed JUN. 22 1978, by B. SUND