


T. 40 S. R. 12 E. W.M.

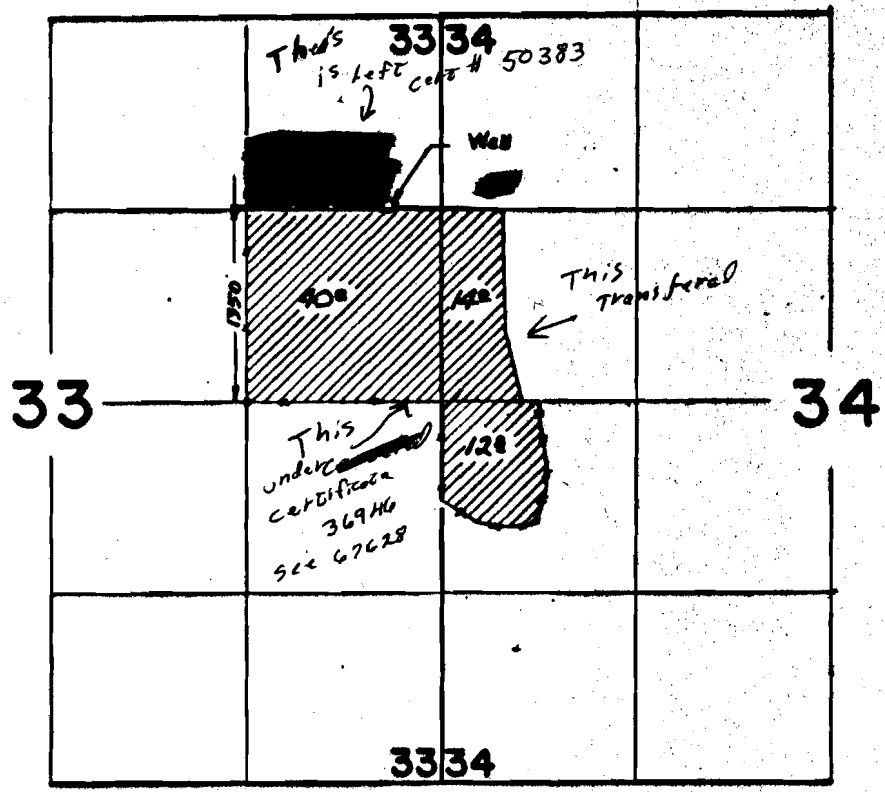

Just finer wells

FINAL PROOF SURVEY UNDER

Application No. G 3397... Permit No. G 3104...
IN NAME OF

MARY L. DRAKE & MICHAEL J. McAULIFFE

Surveyed 12 JUNE 1969, by W. J. RUPPERT...