


R-4613
30627

T398 RIZE WM

50385
50384

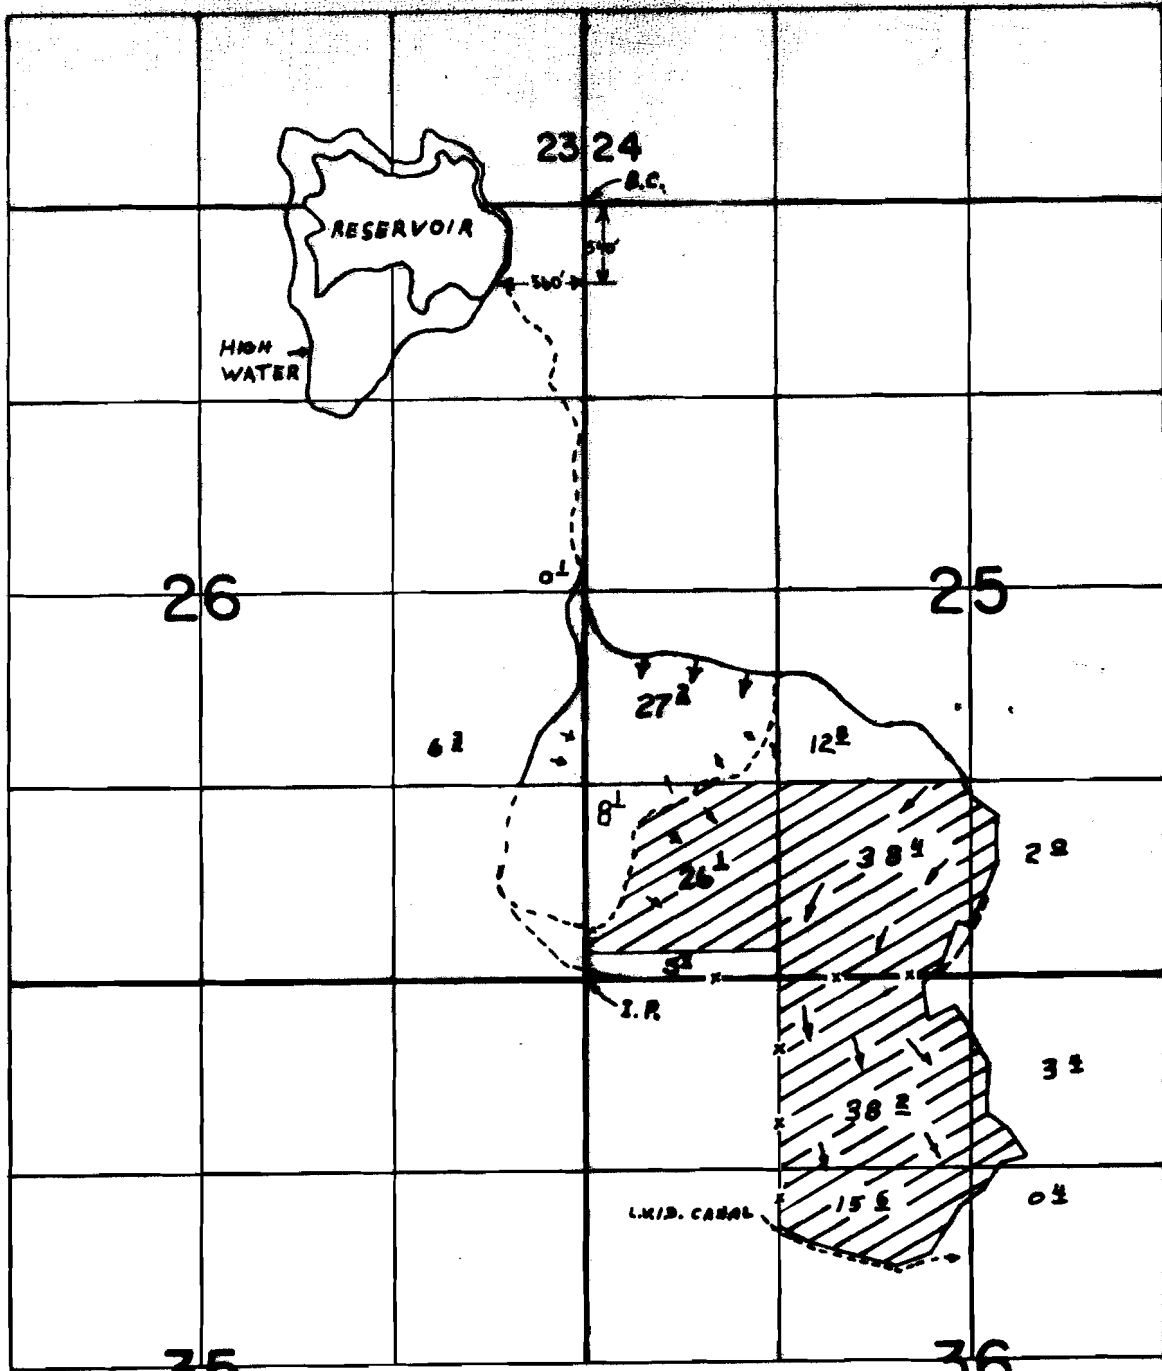

35 **FINAL PROOF SURVEY** 36

UNDER

R-40500 R-4613
Application No. 40501 Permit No. 30627
IN NAME OF

CIRCLE FIVE RANCH, INC.

Surveyed O.G.T. 18, 1977, by R.G. MUCKEN.....