


T39S. R4E. WM

R-4613
30627

50385
50384

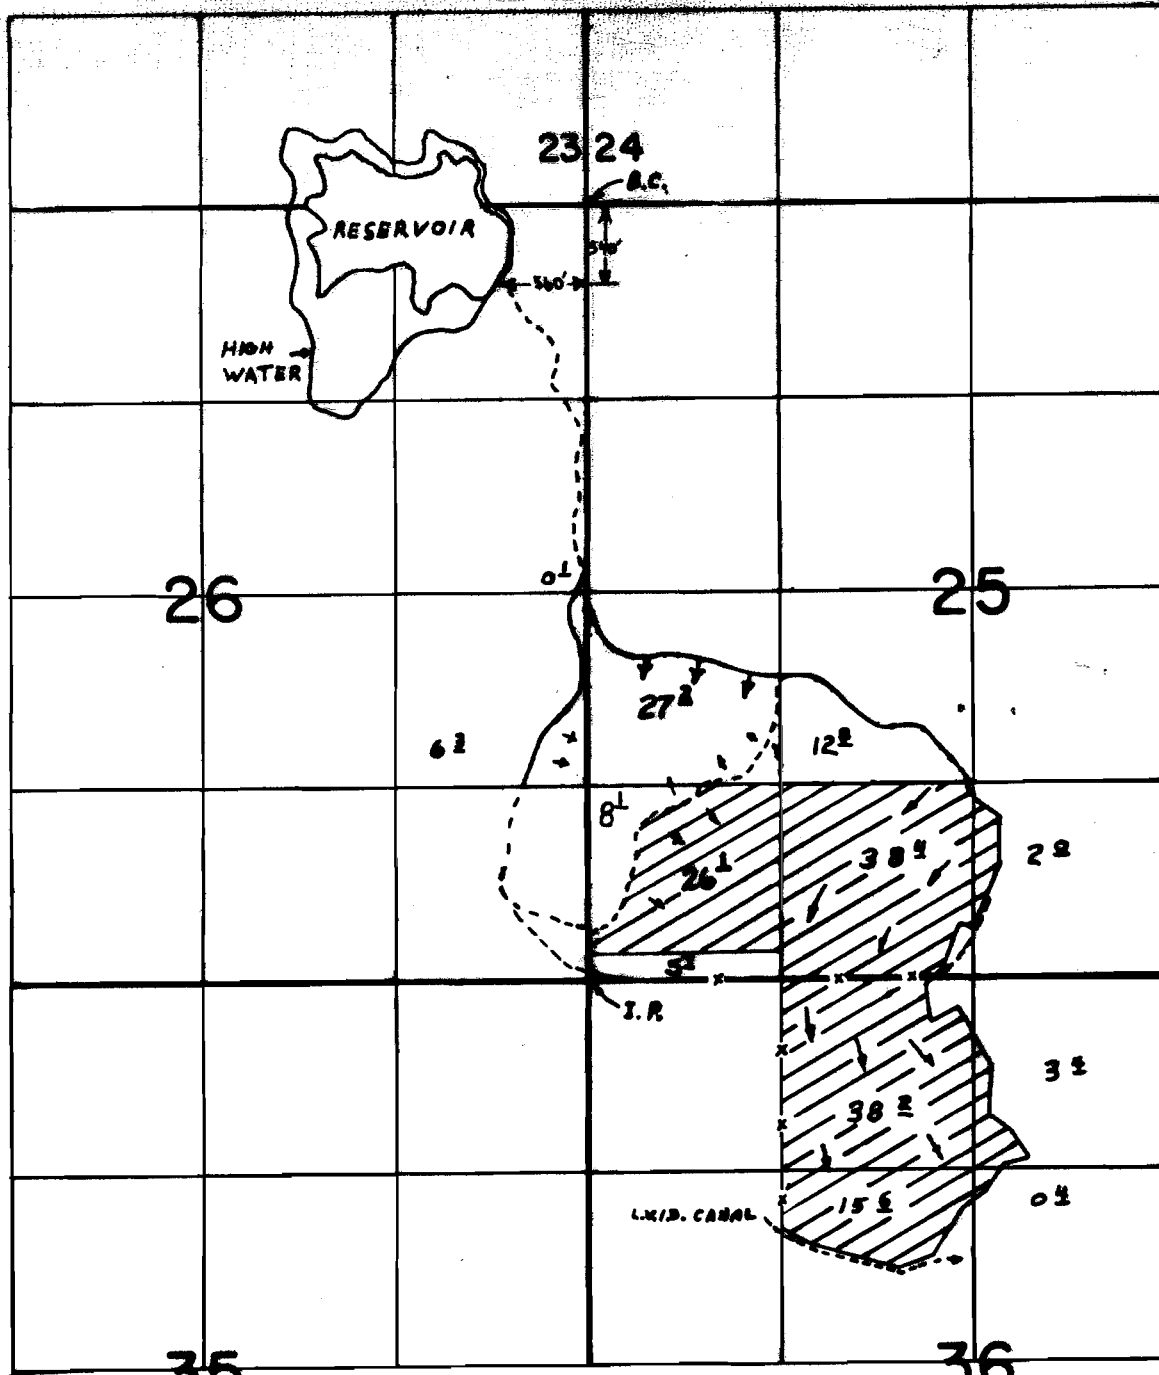

35 FINAL PROOF SURVEY 36 UNDER


R-40500 R-4613
Application No. 40501 Permit No. 30627
IN NAME OF

CIRCLE FIVE RANCH, INC.

Surveyed Q.C.T. 18, 1977, by B.G. MUCKEN

T.39S. R.12E.W.M.

30627
50385

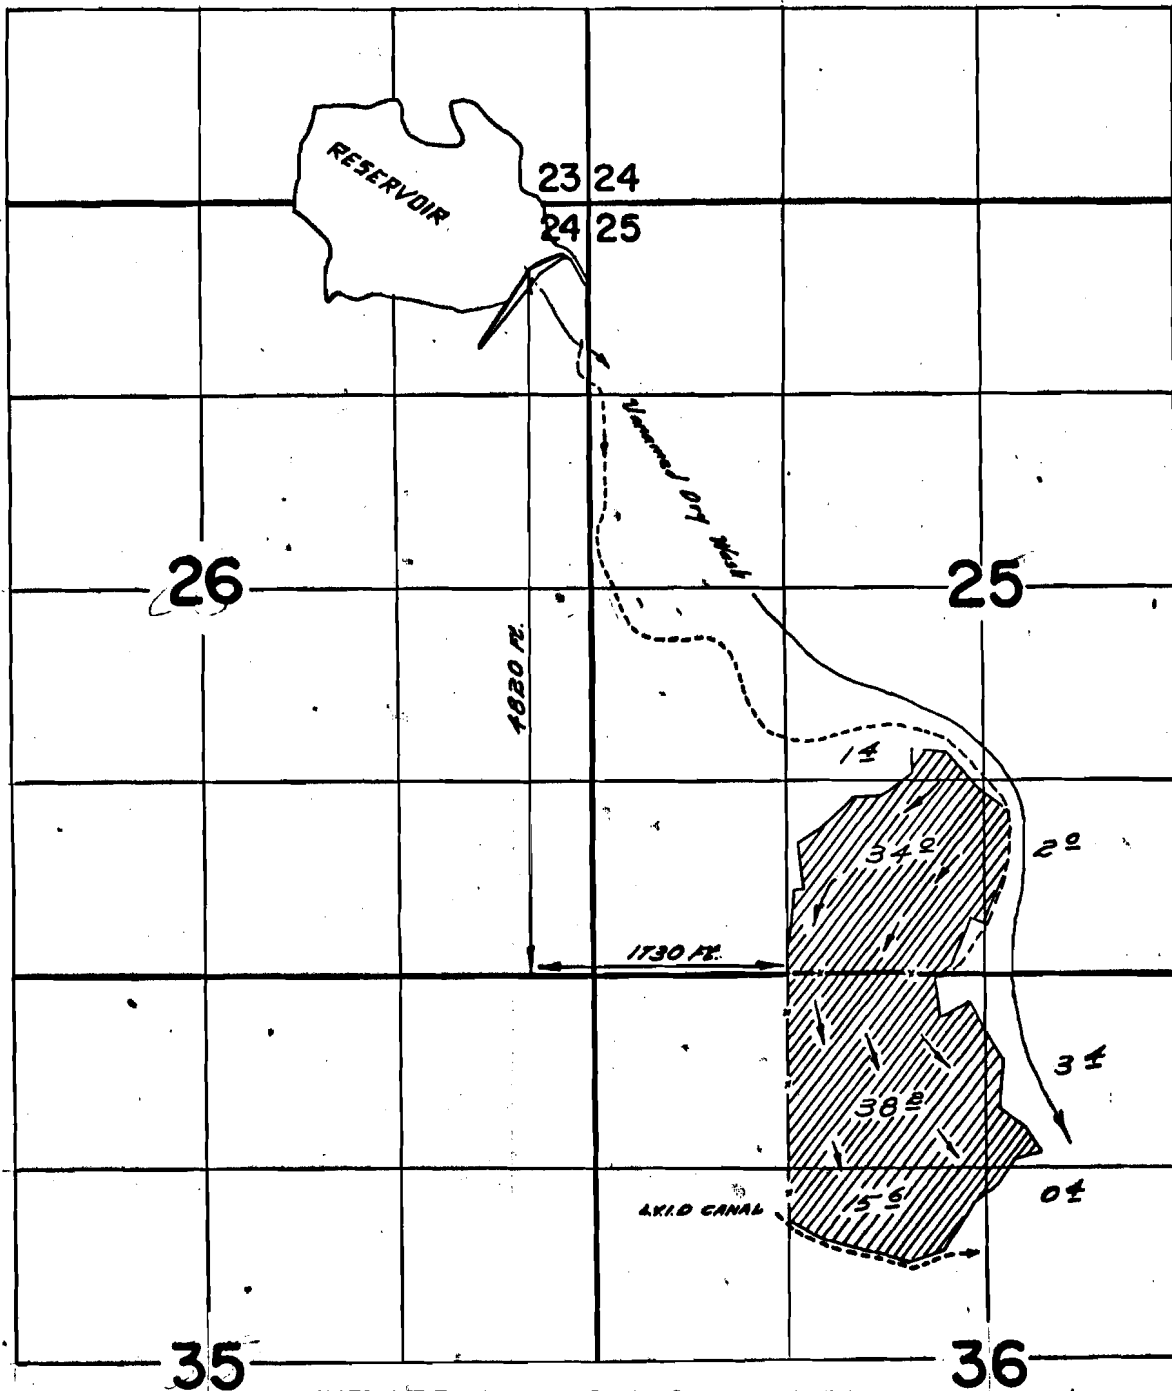

Miller Cole & Assoc.

FINAL PROOF SURVEY
UNDER

R-40500 R-4613
Application No. 40501 Permit No. 30627.
IN NAME OF

LOUIS E. RANDALL

Surveyed date 2/9/1962, by *Wid. Fuppard*