


46574  
50387  
T 4869  
76422  
T 4869  
T 9415

T. 28 S., R. 15 E., W.M.

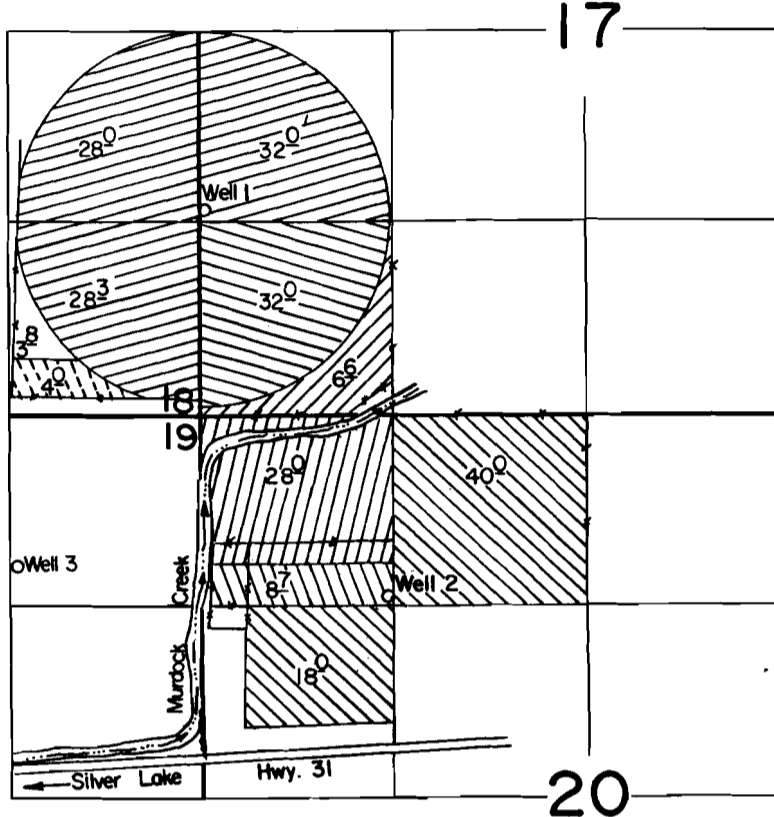

Well 1 Loc.: 1400' N. & 20' E.  
 Well 2 Loc.: 1250' S. & 1290' E.  
 Well 3 Loc.: 1040' S. & 1250' W. ; all from NW Cor. Sec. 20.

Scale: 1" = 1320'

### FINAL PROOF SURVEY

UNDER

G-10411  
G-10384

Application No. G-11196.... Permit No. G-10330....


IN NAME OF

## LAWRENCE & MARJORIE IVERSON

Surveyed Sept. 16.... 1985., by .T. Warren.....

	Primary	Supp.
T- 4868		
T- 4869		
G- 9599		
G- 9463		

# T.28S.R.15E.W.M.

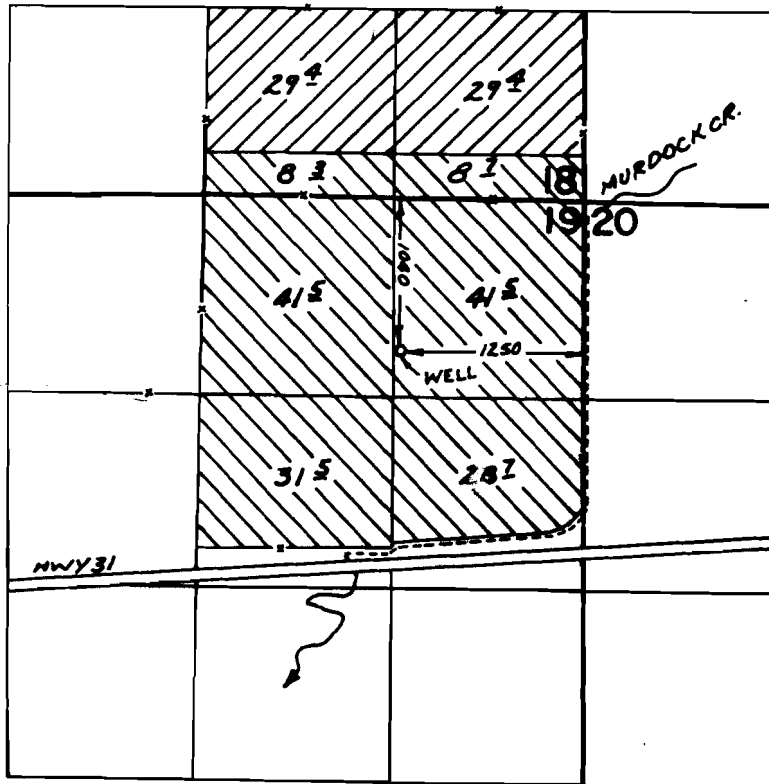

## FINAL PROOF SURVEY UNDER

Application No. G-6047 Permit No. G-5739   
G-6586 G-6174   
 IN NAME OF

LAWRENCE & MARJORIE IVERSON

Surveyed OCT. 27, 1976, by R. MUCKEN