


T. 24 S.R.18 E.W.M.

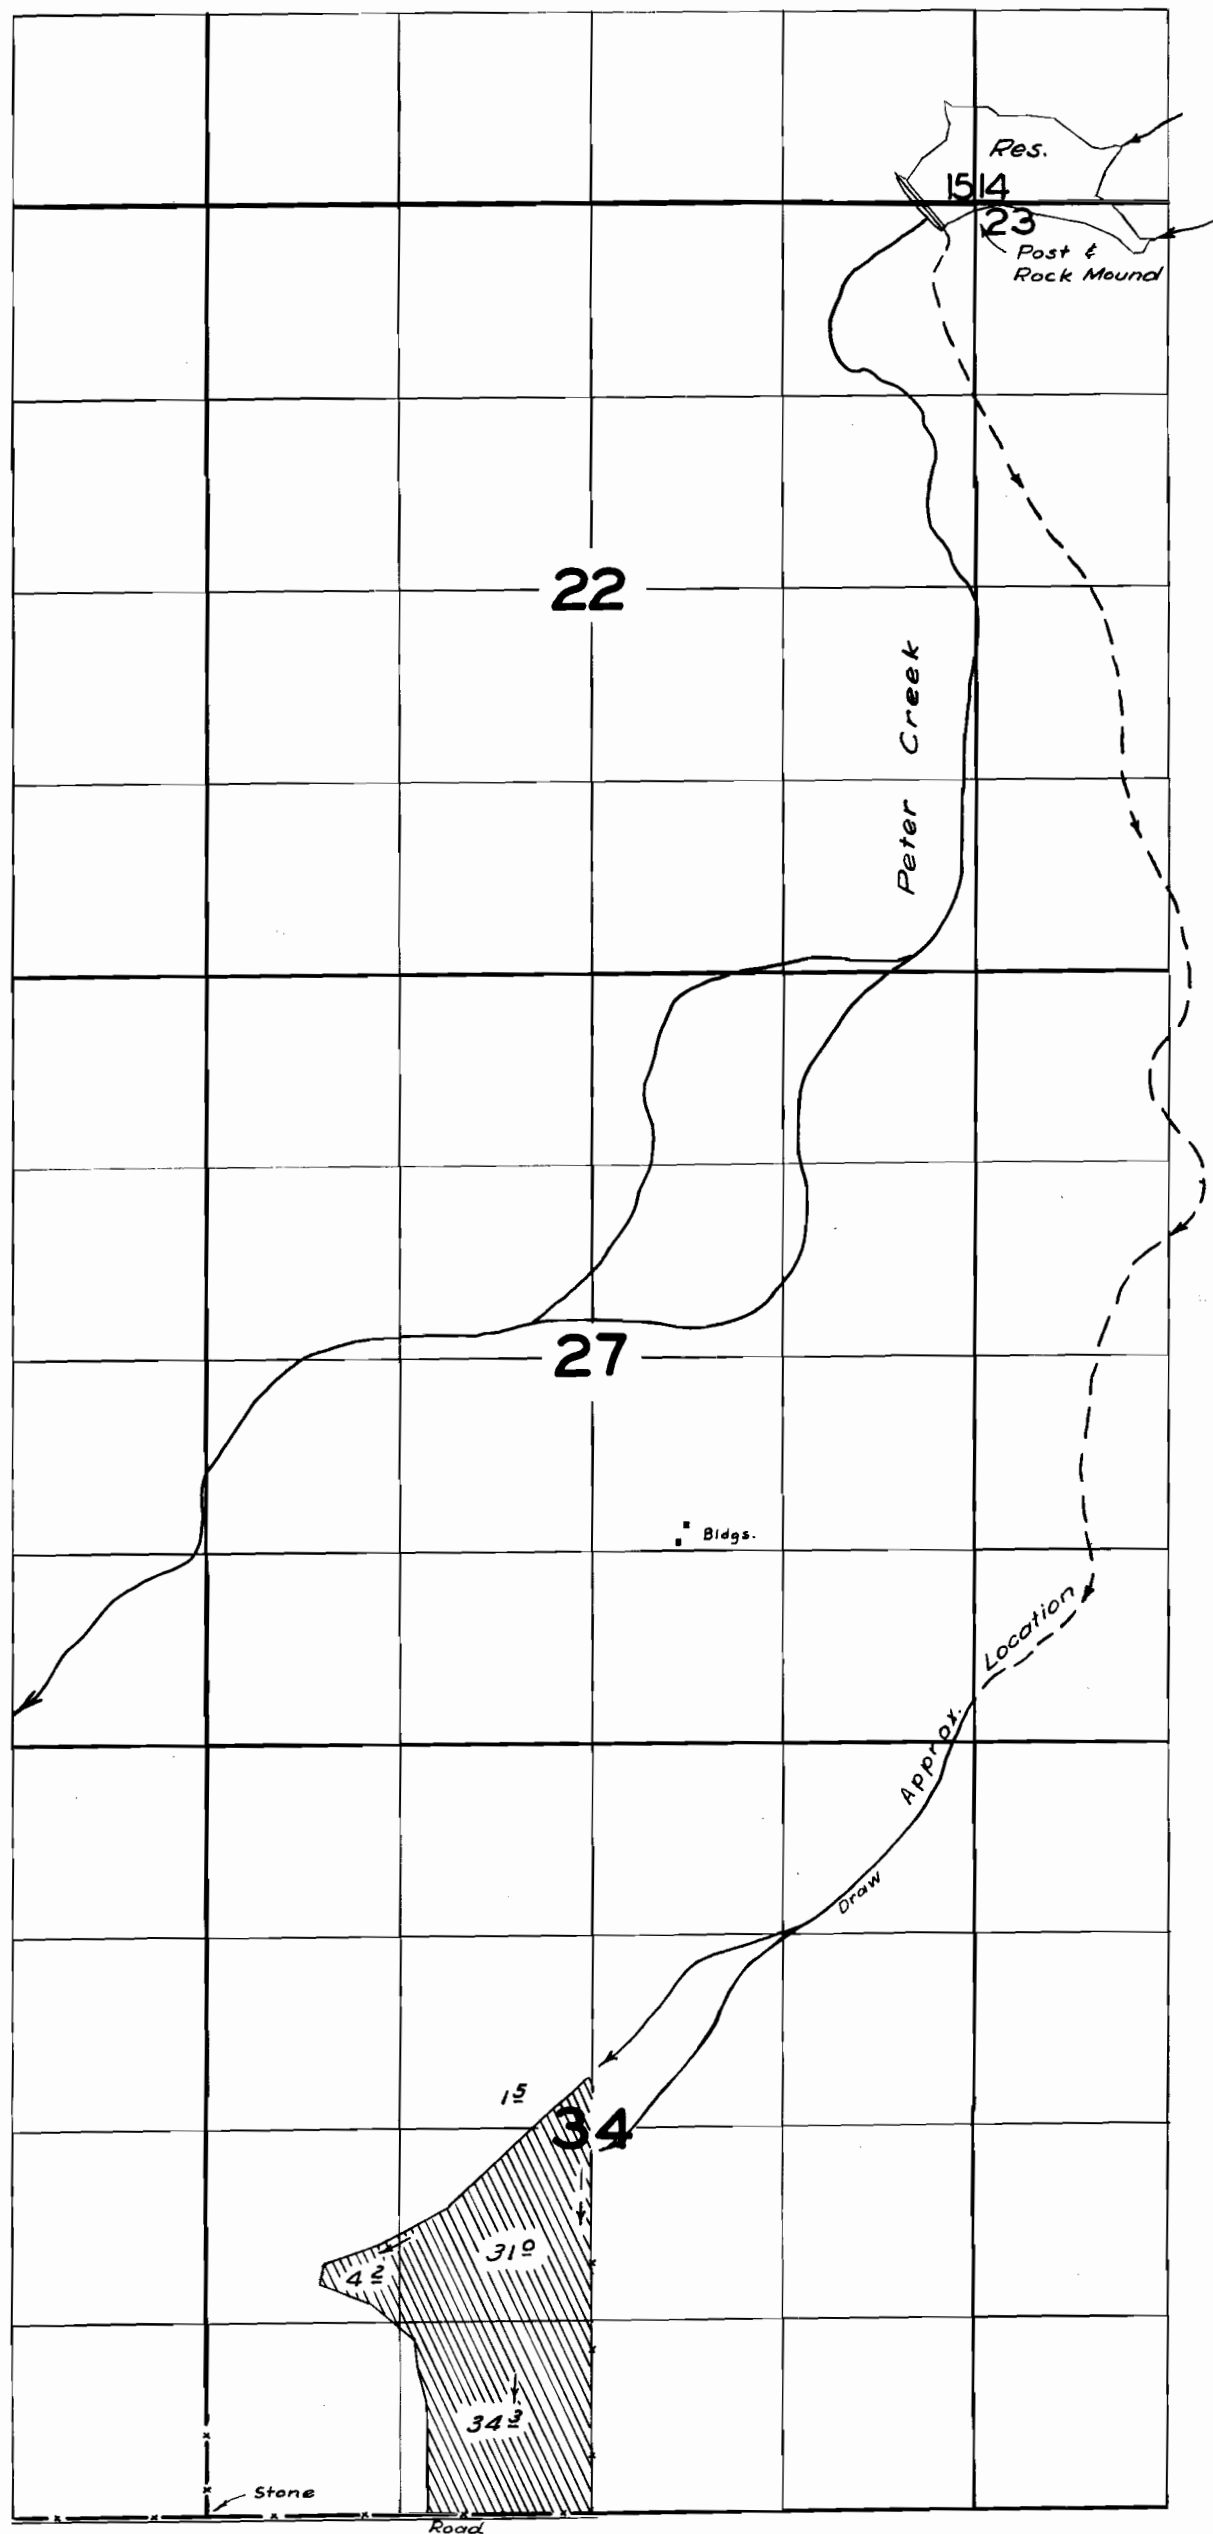

FINAL PROOF SURVEY

UNDER

Application No. 25601 Permit No. 20229
R-25438 R-1142

IN NAME OF

ELLIS G. & IVAN T. PAINTER

Surveyed 16 May 1959, by M. Bish