


T.21 S.R.2 W.W.M.

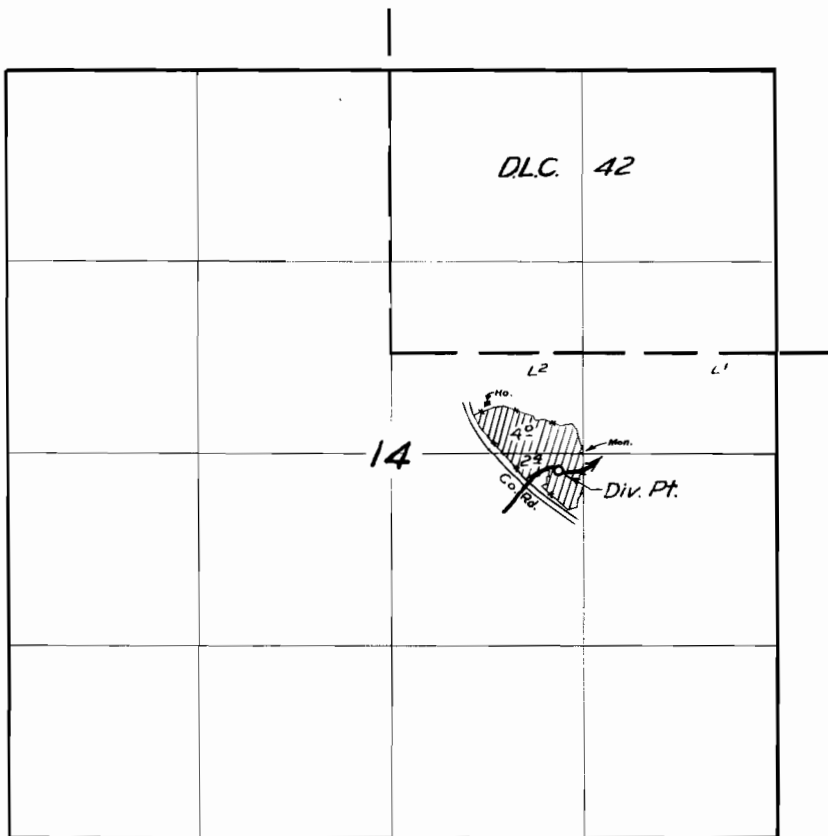

FINAL PROOF SURVEY
UNDER

Application No. 29826 Permit No. 23460
IN NAME OF

Ralph O. Warren

Surveyed April 11, 1957, by M. Bish