


# T14S. R.39E. W.M.

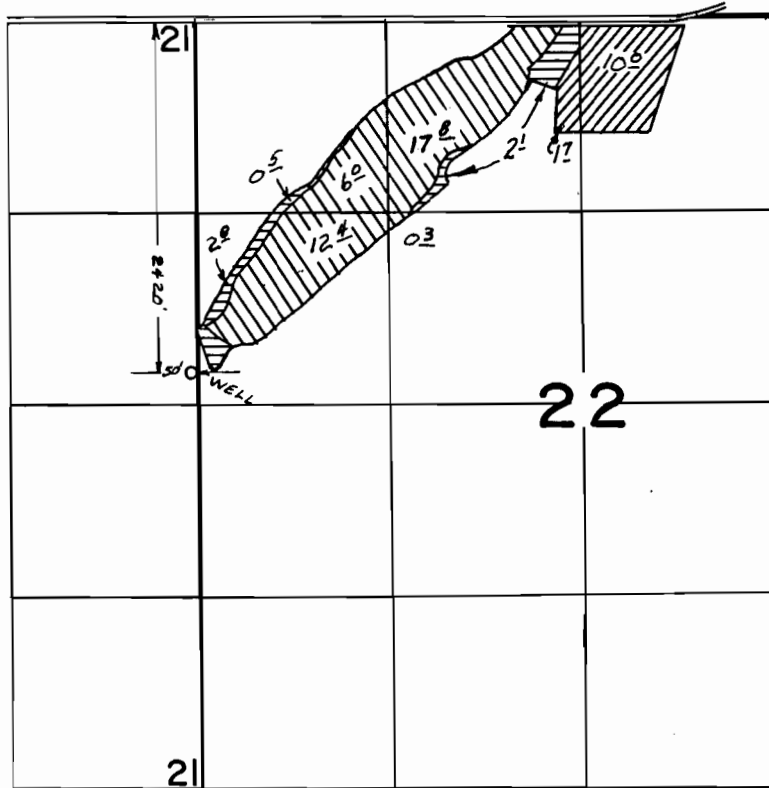

## FINAL PROOF SURVEY UNDER

Application No. G-10636 G-9926  
 G-7094 Permit No. G-6562  
 IN NAME OF

STEVE COLEMAN

AUG 23 1985 L.M. TOLL  
 Surveyed JUN 23 1978, by L.H. NUNN

Suppl.  
  


Primary  
