


**T.5S.R.1W.W.M.**

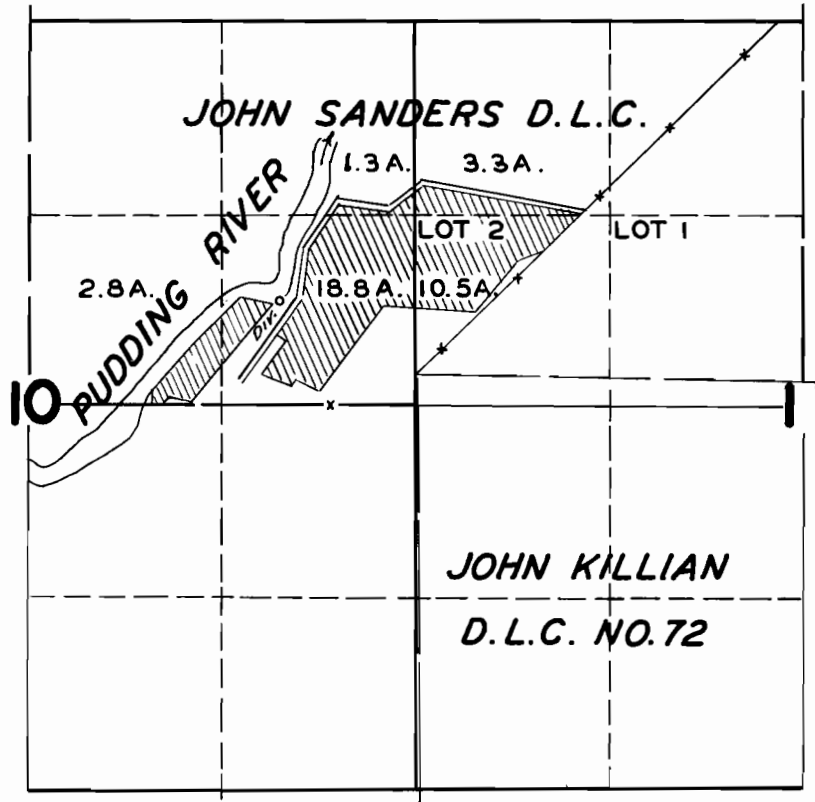

**FINAL PROOF SURVEY**

UNDER

Application No. **21857**... Permit No. **17191**...  
IN NAME OF

**JOHN W. RAMAGE**

Surveyed **MAY 2**, 1949, by **JAS. E. BUNNELL**