


T. 4S. R. 1W. W.M.

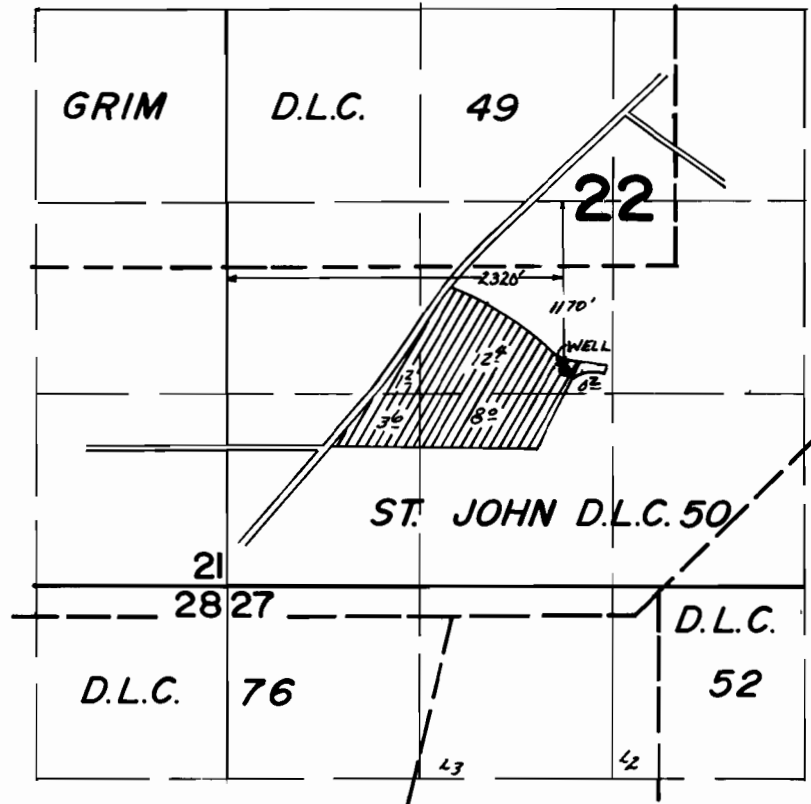

FINAL PROOF SURVEY UNDER

Application No. G-7518. Permit No. G-6992.
IN NAME OF

.....EVERT FREDERIKS.....

Surveyed Aug...16. 1978., by J.S. Donaldson...