


# T. 5 S., R. 1 W., W.M.

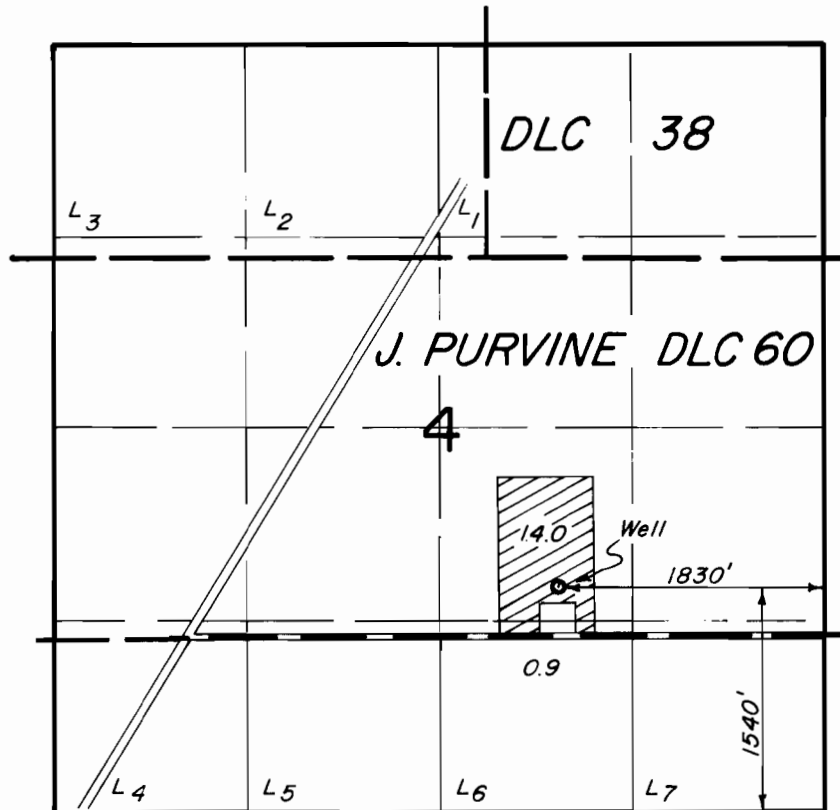

## FINAL PROOF SURVEY UNDER

Application No. G-7738 Permit No. G-7723  
IN NAME OF

**STEFAN TIPIKIN**

Surveyed AUG. 14, 1978, by S. DONALDSON