


T. 7 & 8 S. R. 4 W. W.M.

T-6456

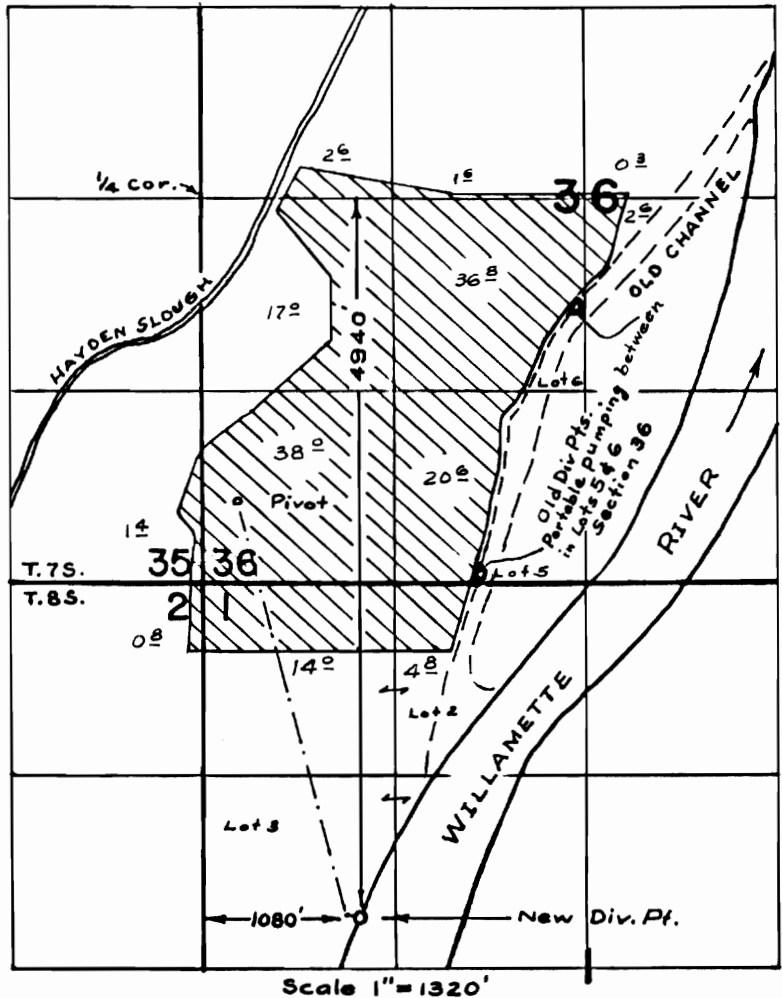

CHANGE IN POINT OF DIVERSION  
 MAP FOR  
 PERMIT No. 15237  
 GREEN VILLA FARMS

THE PREPARATION OF THIS MAP IS FOR THE PURPOSE OF IDENTIFYING THE LOCATION OF THE WATER RIGHT ONLY AND HAS NO INTENT TO PROVIDE DIMENSIONS OR LOCATION OF PROPERTY OWNERSHIP LINES.

