


OFFICE OF STATE ENGINEER
 RECEIVED

MAP


To accompany application for
 permit to appropriate water.

Point of Use
 $S 48^{\circ} - 28' E, 2637'$
 from N.W. Cor. Sec. 13.

Point of divergence
 $S 55^{\circ} 37' E, 3271'$ from
 N.W. Cor. Sec. 13 T. 45 R. 10 W. W.M.

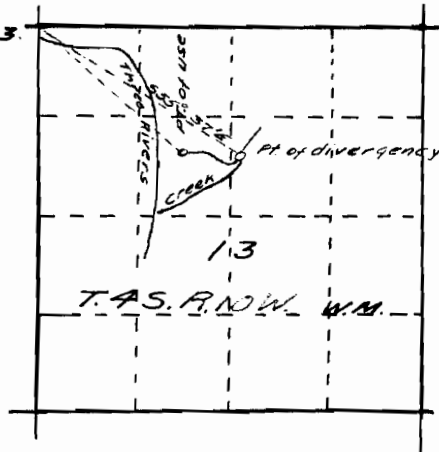

Profile of Dam.

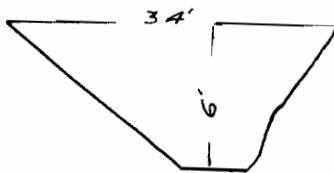

X Section of Dam



I, Geo. S. Gray, of Cloverdale Ore, do hereby certify that this map was made from notes taken during an actual survey made by me on Aug. 13, 1923, and that it correctly represents the works described in the accompanying application, together with the location of streams in the vicinity.

Geo. S. Gray

Reg. Professional Eng.

No. 1196 - March 11, 1921.

APPLICATION No. 9156
 Permit No. 6015