


T.1&2S.R.43E.W.M.

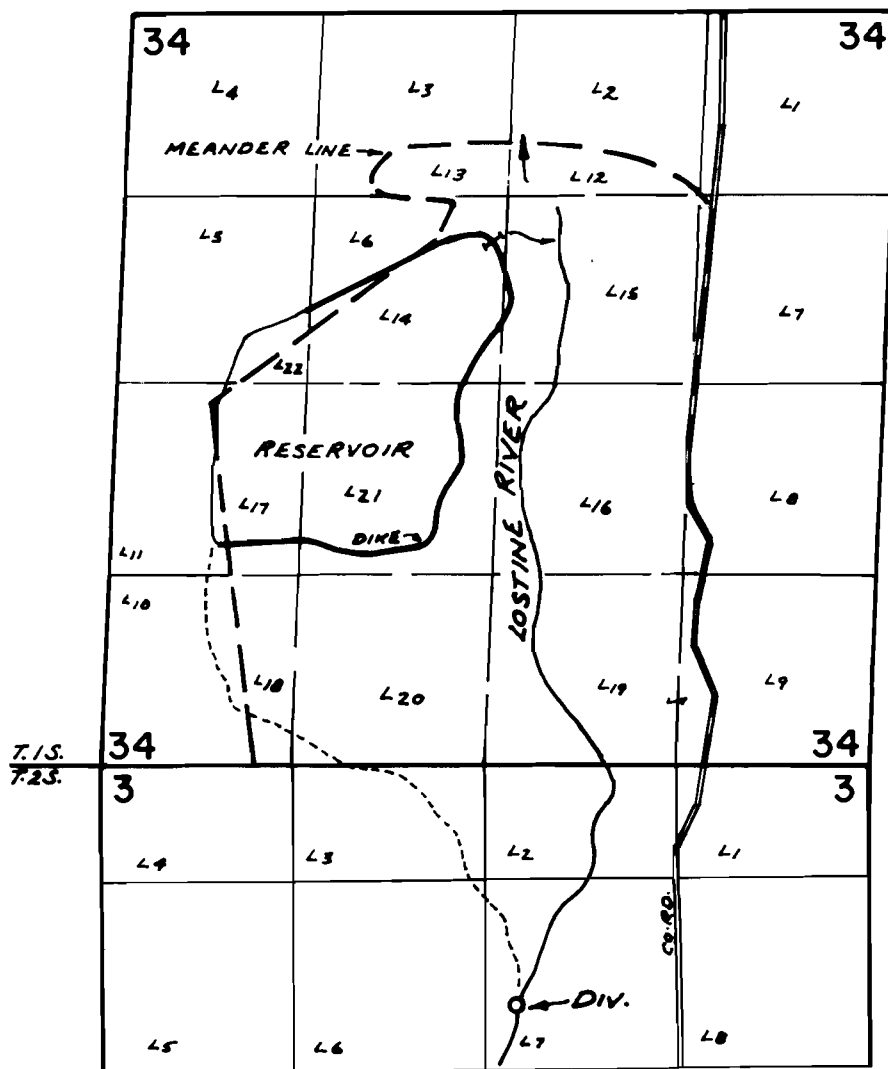

DIV. PTS. LOC: RIVER - 1650'S. & 2850'E.

RES. - 3600'N. & 2700'E, BOTH FROM S.W. COR. SEC.34

FINAL PROOF SURVEY UNDER

Application No. R-46233 Permit No. R-5440
46234 34207
IN NAME OF

BRUCE M. STRATHEARN

Surveyed SEPT.29 1976, by R. MUCKEN