


T19S. R11W. WM.

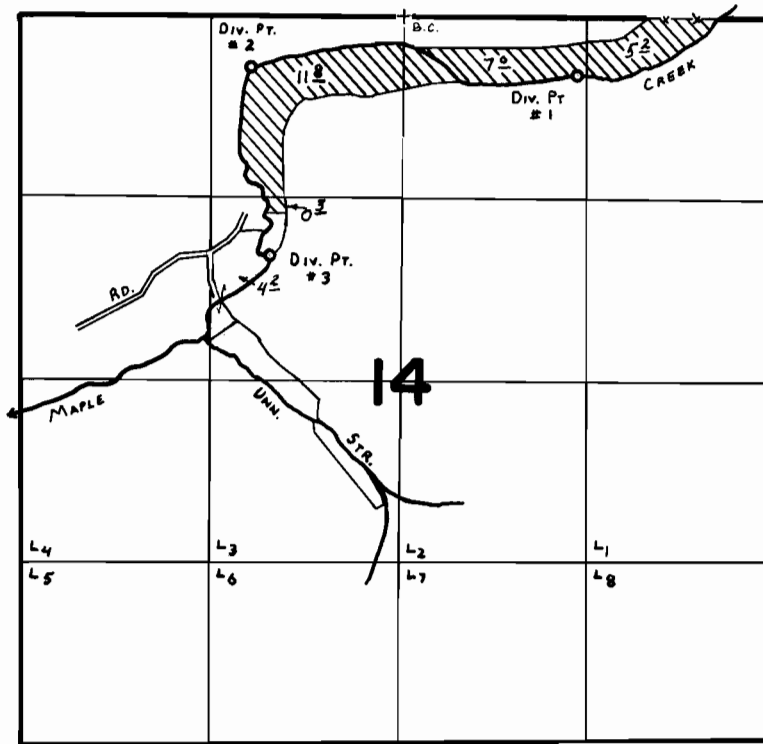

Div. Pts. Loc: #1- 400'S. & 1190'E. }
 #2- 360'S. & 1040'W. } ALL FROM N. 1/4 COR. SEC. 14.
 #3- 1650'S. & 900'W. }

FINAL PROOF SURVEY UNDER

Application No. 42364 Permit No. 31938
 IN NAME OF
GORDON W. & DONNA B. JOHNSON
WILLIAM F. & MARJORIE M. HILL

Surveyed JULY 26 1978, by C. L. HUGHES