


# T.35 S., R.4 W., W.M.

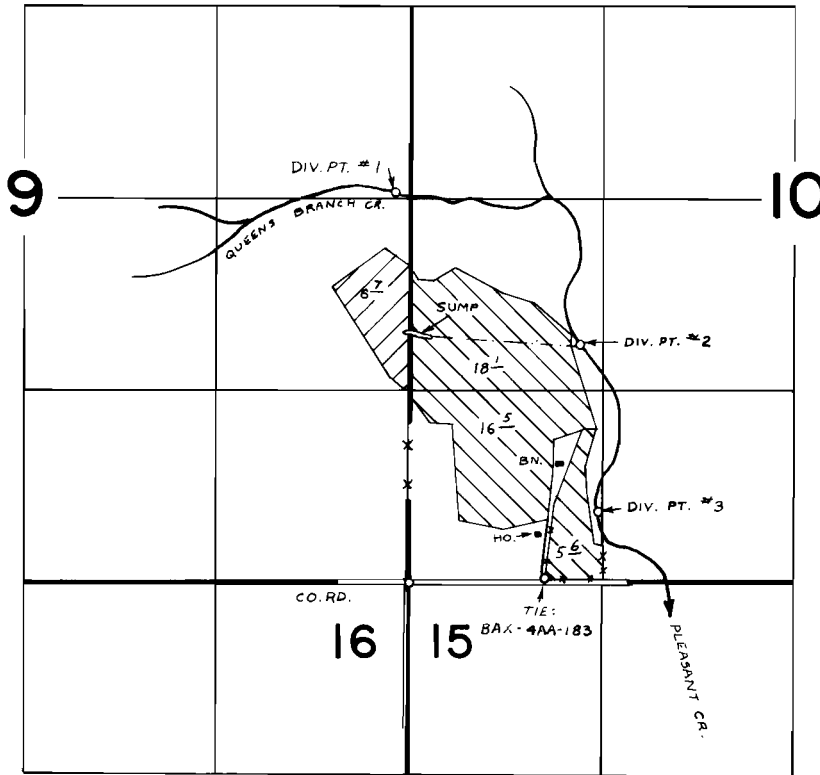

SUMP LOC: 1710' N. & 70' E. FROM S.W. COR. SEC. 10  
 DIV. PT. #1 LOC.: 2680' N. & 110' W. FROM S.W. COR. SEC. 10  
 DIV. PT. #2 LOC.: 1630' N. & 1160' E. FROM S.W. COR. SEC. 10  
 DIV. PT. #3 LOC.: 480' N. & 1300' E. FROM S.W. COR. SEC. 10

## FINAL PROOF SURVEY UNDER

50597                      38239                      SUPPL.  
 Application No. G-5192      Permit No. G-4917      PRIMARY  
 IN NAME OF

GORDON S. & MARILYNN L. ANDERSON

Surveyed AUG. 2 1978, by B. SUND