


T. 36 S., R. 1 W., W. M.

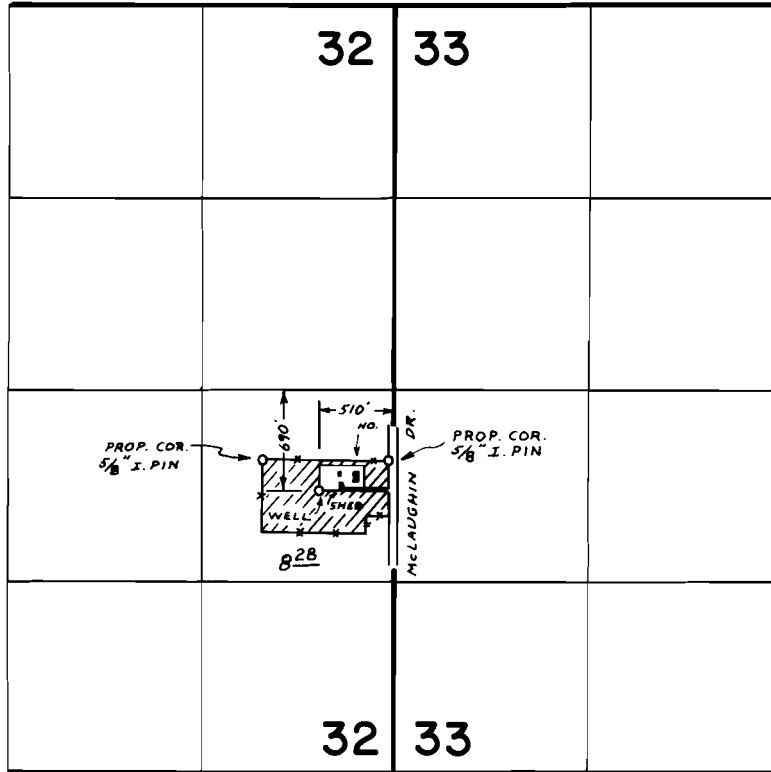

FINAL PROOF SURVEY UNDER

Application No. G-5315 Permit No. G-5140

IN NAME OF

FRANK S. CHAPMAN

Surveyed OCT. 24 1978, by B. SUND