


T.35 S., R.2 W., W.M.

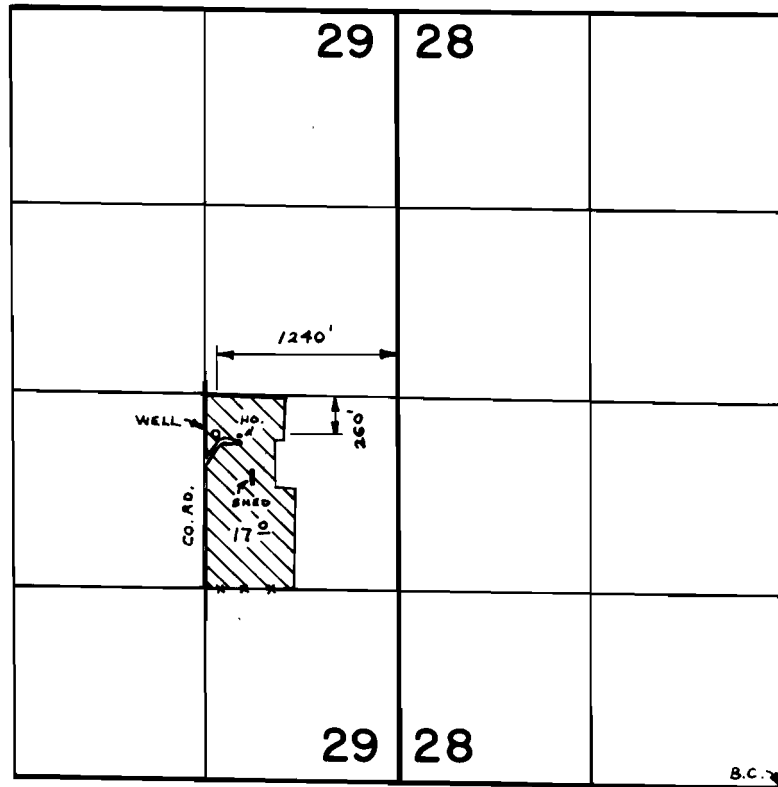

FINAL PROOF SURVEY
UNDER

Application No. G-5655 Permit No. G-5484
IN NAME OF

ROBERT D. NEEL

Surveyed SEPT. 14 1978, by B. SUND

D.H.M.

P.T.S.-1978-14-C
& BAX-3AA-144