


# T. 33 S., R. 1 W., W.M.

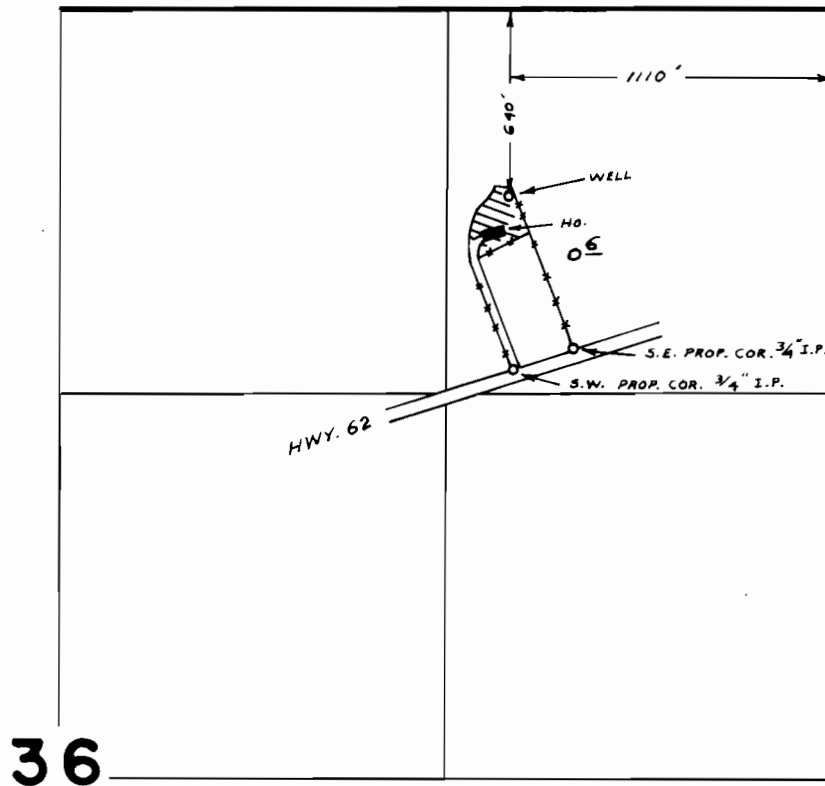

SCALE : 1" = 660 FT.

## FINAL PROOF SURVEY UNDER

Application No. G-5921 Permit No. G-5629  
IN NAME OF

ESTATE OF EDWARD J. GUIDRY

Surveyed AUG. 29 1978, by B. SUND